

Section 35 Township 10 Range 16W

Well No. 4 Krueger

Company Cities Service

Krueger
NORTH

NORTH

WEST

EAST

SOUTH

6

16

6

Rooks KANSAS

Sec. 35 Twp. 10 R. 16W

Well No. #4 Krueger Farm

Cities Service

Company

Krueger Pool (Holmes Drlg. Cont.)

NORTH

Ft. from N. Line

990'


Ft. from S. Line

990'

Ft. from E. Line

Ft. from W. Line

NW SE SE

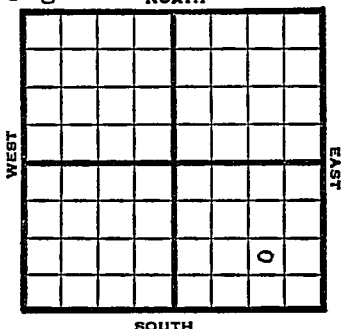

1949

Elev. 2076' REPORT

8/10

RUR

8/17

8" @ 312

Drlg 3080

8/24

Lansing 3253

TD 3560

5" @ 3560

8/31

68 shots 3223-3357 - 2160' W

2 hrs

PB

9/7

88 shots 3252-3304 - 8000 acid

9/14

Pump 86 bbls oil 14 hrs.

9/21

"

10/5

Lans 3253'

5" @ 3560

Perf

8000 acid

Pump 251 oil 9% W

Pot

27° Grav.

TD 3560'

Comp.

COMPLETED

Map No. _____ Sec. 35 Twp. 10 R. 16W

Well No. 4 Krueger

Cities Service

Company

Holmes Drlg.

Contractor

NW SE SE

**FIRST REPORT
SECTION PLAT**

_____ Ft. from N. Line

990

_____ Ft. from S. Line

990

_____ Ft. from E. Line

_____ Ft. from W. Line

			o

Rooks County

RECORD

Location _____

Cased _____ in., _____ ft.

Rig up _____

Sand _____

Drilling and Remarks:

Gas _____

Oil _____

Total Depth _____

R U R

PRODUCTION

1st 24 hrs. Nat. _____

1st 24 hrs. after shot _____

Gas _____ Cu. Ft.

Dry Hole _____

Abandoned _____

Date

AUG 10 1949 19

S. J. LEWIS

Scout

Kansas

Map No. _____ Sec. 35 Twp. 10 R. 16W

Well No. 4 Krueger


Cities Service

Company

COMPLETE

Contractor

NW SE SE

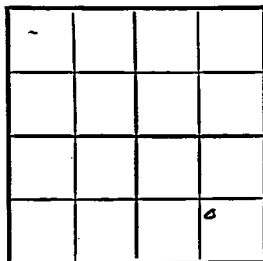F12076.
SECTION PLAT

Ft. from N. Line

990 Ft. from S. Line

990 Ft. from E. Line

Ft. from W. Line

Rooks County

RECORD

Location

Cased _____ in., _____ ft.

Rig up

Sand _____

Drilling and Remarks:

Gas _____

Oil _____

Total Depth 2560

PRODUCTION

1st 24 hrs. Nat. _____

1st 24 hrs. after shot _____

Gas _____ Cu. Ft.

Dry Hole _____

Abandoned _____

Date

OCT 5 1949 19

S. I. LEWIS Scout