

Rooks

KANSAS

Sec. 35 Twp. 10 R. 16 W

Well No. # 4 O'Leary Farm

Cities Service Company

Barbour Contractor

Krueger Pool


Ft. from N. Line

990 Ft. from S. Line

Ft. from E. Line

330 Ft. from W. Line

NW SW SW

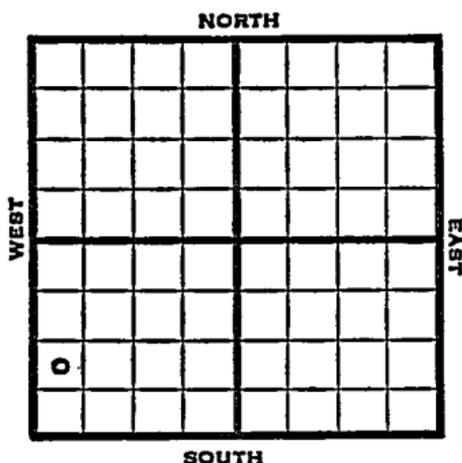

1951 Elev. 2071' REPORT

2/7 Spud 2/3/51
8" @200'
Drlg. 1485'

4/11 Spud 2-3-51
Oil well TD 3571'
8" @ 200 Top 2953 Heeb 3190'
Dodge 3210' Lans 3235' Cong 3560'
TD 3571' 5" @ 3571' 16/3282-97
23/3290-98 24/3281-90 1500 A
P/2 BO 4 BW 8 hr. SP 3276
52/3262-75 B/136 GO 51 GW 7 hr.
1500 A P/6 BO 21 BW 23 hr.
24/3207-13 24/3231-37 1500 A
P/77 BO 32 BWPD
Comp. 124 BOPD 18% water

COMPLETED

