

Sec. 35 Twp. 10 R. 16W ✓

Well No. #3 Krueger Farm

Cities Service

Company

Krueger Pool


_____ Ft. from N. Line

990'

_____ Ft. from S. Line

_____ Ft. from E. Line

330' Ft. from W. Line

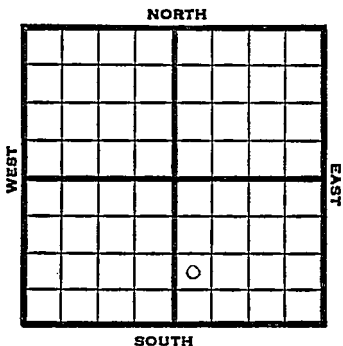

NW SW SE

1949

Elev. 2083' REPORT

6/8

Location

6/15

"

6/21

8" @ 294'

Drlg 1845'

6/28

Drlg 3482'

7/6

Lansing 3256'

TD 3550'

5" @ 3550'

7/12

"

7/20

138 shots 3202-3290'

7/27

Lans. 3256'

5" @ 3550'

Perf

4500 acid

Pump 321 oil & 2% W Pot.

Gr. 29°

TD 3550'

COMPLETED

Rooks County Kansas State

Map No. Sec. 35 Twp. 10 R. 16W

Well No. 3 Krueger

Cities Service Company

Contractor

NW SW SE

FIRST REPORT SECTION PLAT

Ft. from N. Line

990 Ft. from S. Line


Ft. from E. Line

330 Ft. from W. Line

Krueger Pool

Remarks:

Location

 

Date JUN 8 1949

Scout S. J. LEWIS

Krueger Pool

Map No. K64 Sec. 35 Twp. 10 R. 16W

Well No. 3 Krueger

Cities Service Company

COMPLETE

Contractor

NE SW SE

E. 2083
SECTION PLAT

_____ Ft. from N. Line

990 Ft. from S. Line

_____ Ft. from E. Line

330 Ft. from W. Line

		4	

Rooks County

Location _____

Rig up _____

Drilling and Remarks:

*Lease 3256
5" 09050*

*Prof.
4500 acid*

*Pump 321 oil 72%
P.D.*

RECORD

Cased _____ in., _____ ft.

Sand _____

Gas _____

Oil _____

Total Depth 2953

PRODUCTION

1st 24 hrs. Nat. _____

1st 24 hrs. after shot _____

Gas _____ Cu. Ft.

Dry Hole _____

Abandoned _____

29 9/16

Date

JUL 27 1949 19

S. J. LEWIS Scout