

Section 35 Township 10 Range 16-WWell No. #5 KruegerCompany Cities Service
Krueger Pool

NORTH

WEST

EAST

SOUTH

10

0

Rooks

KANSAS

Sec. 35 Twp. 10 R. 16W

Well No. #5 Krueger Farm

Cities Service

Company

Contractor

Krueger Pool

990'

Ft. from N. Line


0 Ft. from S. Line

 Ft. from E. Line

990'

Ft. from W. Line

SE NW SE

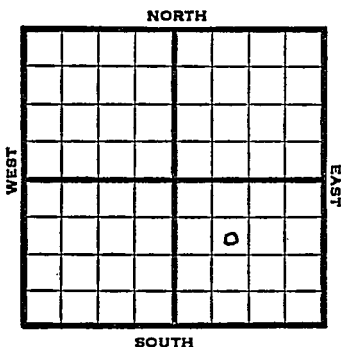

1949

Elev 2094'

REPORT

11/9

Location

11/23

TD 3692'

Lansing 3280'

Arb. 3679'

Aband.

ABANDONED

Map No. _____ Sec. 35 Twp. 10 R. 16W

Well No. 5 Krueger

Cities Service Company

Contractor

SE NW SE

FIRST REPORT
SECTION PLAT

990 Ft. from N. Line

_____ Ft. from S. Line

_____ Ft. from E. Line

990 Ft. from W. Line

Rocks County

Location X

Rig up _____

Drilling and Remarks:

RECORD

Cased _____ in., _____ ft.

Sand _____

Gas _____

Oil _____

Total Depth _____

PRODUCTION

1st 24 hrs. Nat. _____

1st 24 hrs. after shot _____

Gas _____ Cu. Ft.

Dry Hole _____

Abandoned _____

Date

NOV 9 1949 19

S. J. LEWIS

Scout

Map No. _____ Sec. 35 Twp. 10 R. 16W

Well No. 5 Krueger

Cities Service Company

ABANDONED

Contractor

SE NW SE


E 12094
SECTION PLAT

990 Ft. from N. Line

_____ Ft. from S. Line

_____ Ft. from E. Line

990 Ft. from W. Line

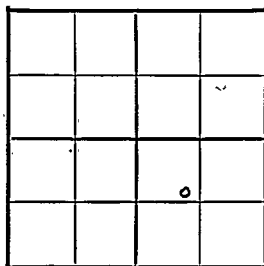

Rooks County

Location _____

Rig up _____

Drilling and Remarks:

Loss 3280

Cost 3679

RECORD

Cased _____ in., _____ ft.

Sand _____

Gas _____

Oil _____

Total Depth 2692

PRODUCTION

1st 24 hrs. Nat. _____

1st 24 hrs. after shot _____

Gas _____ Cu. Ft.

Dry Hole _____

Abandoned _____

Date

NOV 23 1949

19

S. J. LEWIS

Scout