

# KANSAS

Rooks

Section 35 Township 10S Range 16W

Well No. #2 O'Leary

Company Cities Service

NORTH

WEST

EAST

SOUTH

		.					
		o					

14

Sec. 35 Twp. 10 R. 16-W

Well No. #2 O'Leary Farm

Cities Service Company


Krueger

           Ft. from N. Line

990 Ft. from S. Line

990 Ft. from E. Line

           Ft. from W. Line

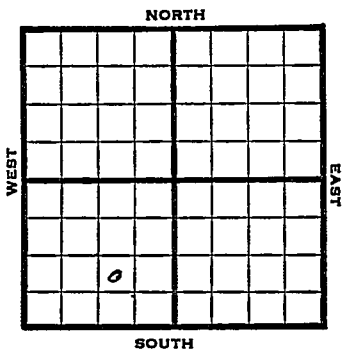

NW SE SW

1949 Elev. 2098' REPORT

10/12 Location  
10/19 8" @ 303'  
Drlg 2780'  
10/26 TD 3550'  
5" @ 3546'  
11/1 Lansing 3270'  
11/9 TD 3550'  
11/16 "  
11/23 5" @ 3546'  
95 shots 3268-3328  
350' oil / 600' W 13 hrs.  
11/29 Squeeze  
12/7 "  
12/14 "  
12/21 TD 3550'  
Lansing 3270'  
5" @ 3546'  
Perf  
4000 acid  
Pump 697 Oil Pot  
27° Gr.  
Comp

**COMPLETED**

Map No. \_\_\_\_\_ Sec. 35 Twp. 10 R. 16W

Well No. 2 O'Leary

Cities Service \_\_\_\_\_ Company

Rine Drlg. \_\_\_\_\_ Contractor

NW SE SW

FIRST REPORT  
SECTION FLAT

\_\_\_\_\_ Ft. from N. Line

990 Ft. from S. Line

990 Ft. from E. Line

\_\_\_\_\_ Ft. from W. Line


Rooks County

Location X

Rig up

Drilling and Remarks:

RECORD

Cased \_\_\_\_\_ in., \_\_\_\_\_ ft.

Sand \_\_\_\_\_

Gas \_\_\_\_\_

Oil \_\_\_\_\_

Total Depth \_\_\_\_\_

PRODUCTION

1st 24 hrs. Nat. \_\_\_\_\_

1st 24 hrs. after shot \_\_\_\_\_

Gas \_\_\_\_\_ Cu. Ft.

Dry Hole \_\_\_\_\_

Abandoned \_\_\_\_\_

Date

OCT 12 1949

19

S. J. LEWIS

Scout

Kansas

Map No. \_\_\_\_\_ Sec. 35 Twp. 10 R. 16W

Well No: 2 O'Leary


Cities Service

Company

COMPLETE

Contractor

NW SE SW

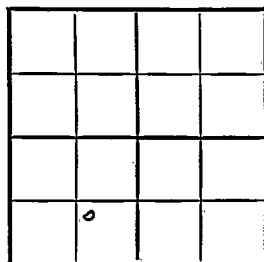E12098  
SECTION PLAT

\_\_\_\_\_ Ft. from N. Line

990 Ft. from S. Line

990 Ft. from E. Line

\_\_\_\_\_ Ft. from W. Line

Rooks. County

Location \_\_\_\_\_

Rig up \_\_\_\_\_

Drilling and Remarks:

*Lease 3270**5" 09546.**Perf.**4000 acid**Pump 697 oil Perf.**27° S*

## RECORD

Cased \_\_\_\_\_ in., \_\_\_\_\_ ft.

Sand \_\_\_\_\_

Gas \_\_\_\_\_

Oil \_\_\_\_\_

Total Depth *3550*

## PRODUCTION

1st 24 hrs. Nat. \_\_\_\_\_

1st 24 hrs. after shot \_\_\_\_\_

Gas \_\_\_\_\_ Cu. Ft.

Dry Hole \_\_\_\_\_

Abandoned \_\_\_\_\_

Date

DEC 21 1949 19

S. J. LEWIS

Scout