KANSAS


FORM 51 5M PETROL

Rooks

Section 35 Township 10 Range 17 W

Well No. #1 National Bank of Topeka

Company Texas

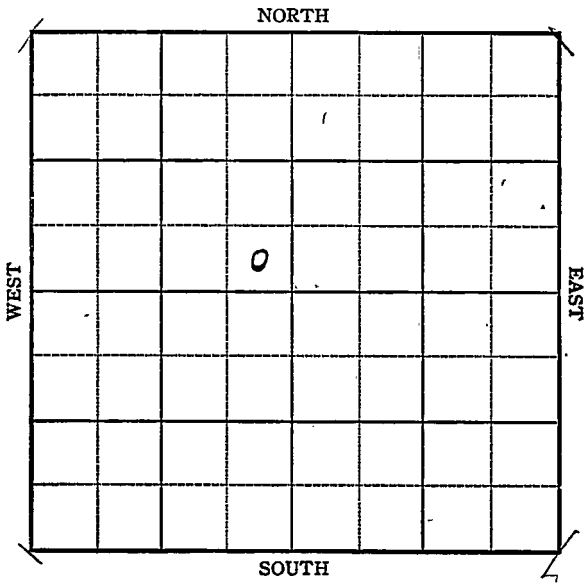


6

FORM 252-A
5M 9-43 GASS KANSAS Rooks

Sec. 35 Twp. 10 R. 17-W

Well No. #1 National Bank of Topeka Farm

Texas Company

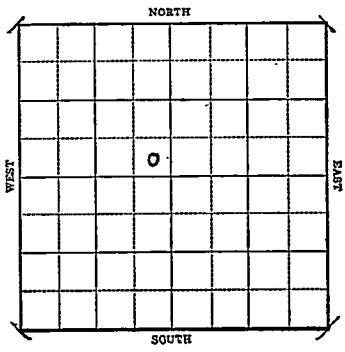

_____ Ft. from N. Line

330 Ft. from S. Line

330 Ft. from E. Line

_____ Ft. from W. Line

1943	REPORT
9/8	Location
9/15	Rotary
9/22	Surface hole
9/29	Anhy 1275' Drlg.
10/6	8" @ 1279' Drlg. 2172'
10/13	Lans 3278 Cong. 3564 Arb 3657 T.D. 3710'

ABANDONED

Form 26 200 Bks. 5-42 Petrol Rooks

KANSAS

Map No. 64 Sec. 35 Twp. 10 R. 17W

Well No. 1 National Bank of Topeka

Texas Company

FIRST REPORT Contractor

SE NW

____ Ft. from N. Line


330 Ft. from S. Line

330 Ft. from E. Line

____ Ft. from W. Line

Wildcat

SECTION PLAT

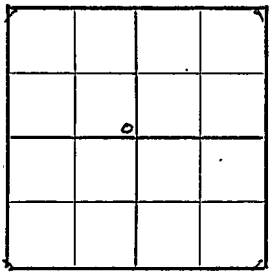

Location X

Rig up

Drilling and Remarks:

RECORD

Cased ____ in., ____ ft.

Sand

Gas

Oil

Total Depth

PRODUCTION

1st 24 hrs. Nat.

1st 24 hrs. after shot

Gas ____ Cu. Ft.

Dry Hole

Abandoned

Date

SEP 8 1943 19 S. J. LEWIS Scout

Form 26 200 Bks 5-42 Petrol

Rooks

KANSAS

Map No. ____ Sec. 35 Twp. 10 R. 17W


Well No. 1 National Bank of Topeka

Texas Company

ABANDONED Contractor

SE NW

SECTION PLAT

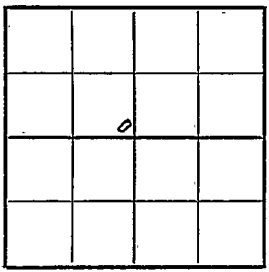

____ Ft. from N. Line

330 Ft. from S. Line

330 Ft. from E. Line

____ Ft. from W. Line

Wildcat

Location

Rig up

Drilling and Remarks:

Lans 3275
Conq 3564
RT 3657

RECORD

Cased ____ in., ____ ft.

Sand

Gas

Oil

Total Depth 3710

PRODUCTION

1st 24 hrs. Nat.

1st 24 hrs. after shot

Gas ____ Cu. Ft.

Dry Hole

Abandoned

Date

OCT 13 1943 19

S. J. LEWIS Scout