Rooks

FORM 51

KANSAS

Section 35 Township 10 Range 17W

Well No. 4 - Brungardt.

Company Champlin Refg.

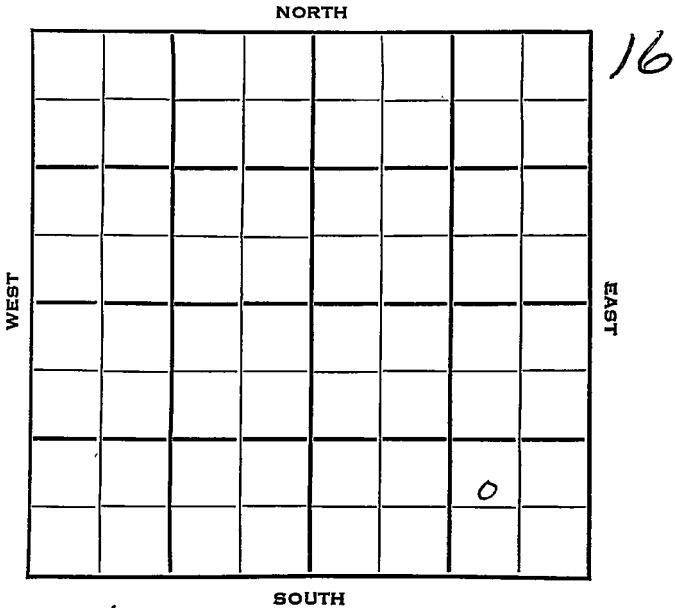

FORM 252-B

Rooks KANSAS ✓

Sec. 35 Twp. 10 R. 17 W

Well No. # 4 Brungardt Farm

Champlin Ref. Company

Champlin Contractor

* Ft. from N. Line

990 Ft. from S. Line

990 Ft. from E. Line

Ft. from W. Line

NW SE SE

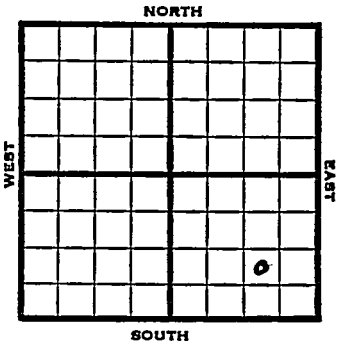

1952	Elev. 1968' REPORT
12/30	RUR
1/1	RUR
1/8	8" @ 153 Anhy 1172 Topaka 2882 Heeb 3110
1/15	Lans 3154 DST 3117-67, 1½ hrs., rec. 105 HOCM, DST 3248-63, 3/4 hrs., 210' SW Cong 3443 DST 3444-66, ½ hr., 1550' oil Arb 3542 RTD 3560, running Schl
1/22	5" @ 3566
1/29	CO 3529 58/3449-70, S/22 BFPH 6% wtr. S/175 BO 8 hrs.
2/5	NR
2/12	NR
2/19	NR
2/26	NR

OVER

#4 Brungardt

1953
3/4

Spud 12-27-52
Oil Well
TD 3566
Anhy 1172, Top 2882
8" @ 153
Heeb 3110, Lans 3154
DST 3117-67, opn ½ hr., rec.
105' hocm, 970#
DST 3248-63, opn 3/4 hrs., rec.
210' sw, 0#
Cong 3443
DST 3444-66, opn ½ hr., rec.
1550' oil, 842#
Arb 3542
TD 3566
5" @ 3566
CO to 3529
58/3449-70 S/22 bfph 6% wtr.
S/175 bo 8 hr.
Comp. 114 bopd 36% wtr.

COMPLETED

FORM 275 FOR SALE BY KANSAS BLUE PRINT CO.

County Rooks State Kansas

Sec. 35 (Blk. Twp.) 10 (Sur. Rge.) 17W Map No.

Operator Champlin Ref.

Well No. 4 Farm Brungardt

Elev. Location NW SE SE

990 Ft. From S Line SE

990 Ft. From W Line Quarter

1st. Report DEC 30 1952

Completion

Remarks

Champlin - Contr.

Spudding Date

FIRST REPORT

Drlg. Data

RUR

J. G. McGEHEE

FORM 275 FOR SALE BY KANSAS BLUE PRINT CO.

County Rooks State Kansas

Sec. 35 (Blk. Twp.) 10 (Sur. Rge.) 17W Map No.

Operator Champlin Ref.

Well No. 4 Farm Brungardt

Elev. 1968 Location NW SE SE

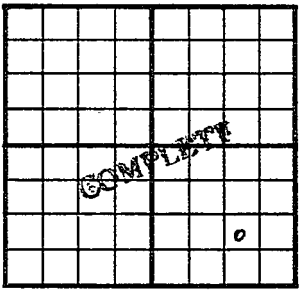

990 Ft. From S Line SE

990 Ft. From E Line Quarter

1st. Report

Completion MAR 4 1953

Remarks

Champlin - Contr.

Spudding Date 12-27-52

Drlg. Data Oil well TD 3566

Anhy 1172 Top. 2882 8" @ 153

Heeb. 3110 Lans. 3154 DST 3117-67

open ½ hr. Rec. 105' hocm 970#

DST 3248-63 open 3/4 hr. Rec. 210' sw

0# Cong. 3443 DST 3444-66 open ½ hr.

Rec. 1550' oil 842# Arb. 3542

TD 3566 5" @ 3566 CO to 3529

58/ 3449-70 S/ 22 bfph 6% wtr.

S/ 175 bo 8 hr.

Comp. 114 bopd 36% wtr.

J. G. McGEHEE