

KANSAS

Company Champlin Ref.

EAST

SOUTH

15

Rooks

KANSAS ✓

Sec. 35 Twp. 10 R. 17WWell No. #9 Brungardt Farm

Champlin Ref.

Company

Champlin

Contractor

Ft. from N. Line

NORTH

330


Ft. from S. Line

Ft. from E. Line

330

Ft. from W. Line

SW SW SE

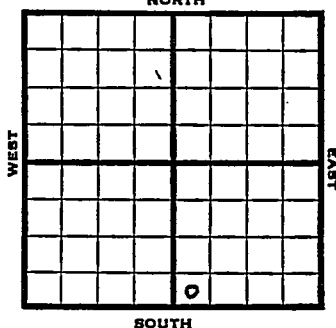

1953

Elev. 2073' REPORT

4/15

Spud 4-13-53
8" @ 160'

4/23

Anhy 1280
Drlg. 3090'

4/30

Heeb 3223, Lans 3266

DST 3228-73, 1/2 hrs., 6' M, 240#
Cong 3554

DST 3533-64, 1/2 hrs., 15' m, 230#

DST 3563-78, 3/4 hrs., 540' oil, 300'
wtr., 920#

Simp 3610, Arb. 3642

RTD 3659 Schl

5" @ 3653'

5/6

WOCT

5/20

Spud 4-13-53 Oil well TD 3654
8" @ 160' Anhy 1280 Heeb 3223
Lans 3266DST 3228-73 open 1/2 hr rec 6' mud 240#
Cong. 3554

DST 3533-64 open 1/2 hr rec 15' mud 230#

DST 3563-78 open 3/4 hr. rec 540' oil
300' wtr. 920# Simp. 3610 Arb 3642

TD 3654 5" @ 3653 GO to 3649

21/3643-48 Perf/3643-44 3643-48

1 BOPH 250 A S/74 BF 3 hr.

Comp. 480 BOPD

COMPLETED

County Books State Kansas

Sec. **35** (Blk.) **10** (Sur.) **17W** Map No.

Operator Chamolin Ref.

Well No. **9** Farm **Brungardt**

Elev.	Location	SW	SW	SE
-------	----------	----	----	----

330 Ft. From S Line SE

330 Ft. From W Line Quarter

1st. Report APR 15 1953

Completion

Remarks.

Champlin - Contr.


Spudding Date **4-13-53**

Drlg. Data

8th @ 160

J. G. McGEHEE

County _____ Rocks _____ State _____ Kansas
 Sec. 35 (Blk.) 10 (Sur.) 17W Map No.
 Operator Champlin Ref.
 Well No. 9 Farm Brungardt
 Elev. 2073 Location SW SW SE

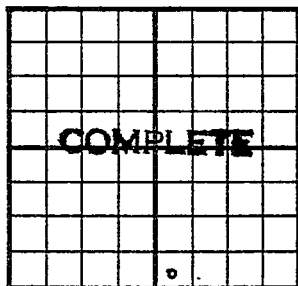

330 Ft. From S Line SE
 330 Ft. From W Line Quarter

1st. Report

Completion MAY 20 1953

Remarks

Champlin - Contr.

Spudding Date 4-13-53

Drlg. Data Oil well TD 3654

8" @ 160 Anhy 1280 Heeb. 3223

Lans. 3266 DST 3228-73 open $\frac{1}{2}$ hr.

Rec. 6' mud 240# Cong. 3554

DST 3533-64 open $\frac{1}{2}$ hr. Rec. 15' mud

230# DST 3563-78 open $\frac{3}{4}$ hr. Rec.

540' oil . 300' wtr. 920# Simp. 3610

Arb. 3642 TD 3654 5" @ 3653

CO to 3649 21/ 3643-48 Perf/ 3643-44

3643-48 1 boph 250 A S/ 74 bf 3 hr.

Comp. 480 bopd

J. G. McGEHEE