

Section 35 Township 10 Range 17WWell No. 11 BrungardtCompany Champlin Refg.

NORTH

WEST

EAST

SOUTH

12

0

Rooks

KANSAS

SEC.	TWP.	R.
35	10	17 W

WELL NO.

11 Brungardt

FARM

COMPANY

Champlin Ref.

CONTRACTOR

Brungardt Pool

990

Ft. from N. Line


Ft. from S. Line

Ft. from E. Line

990

Ft. from W. Line

SE NW SW

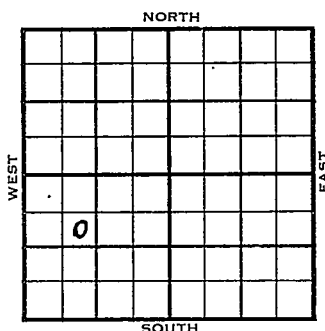

1955

ELEVATION

2083'

REPORT

3/9

5/25

Location

Top 3006; Heeb 3231; Lsg 3272;
 B.K.C. 3534; Congl 3564; Arb 3641;
 TD 3650; 8 5/8" 148;
 DST 3313-36 open 1 hr., rec 280'
 sw, 910#;
 DST 3545-71 open 2 hrs, rec 40' drlg
 mud, specks oil, 0#;
 DST 3552-81 open 2 hrs, rec 35' drlg
 mud, 0#
 DST 3560-3601 open 2 hrs. rec 15'
 muddy sw, 0#;
 DST 3646-50 open 2 hrs, rec 370'
 free oil, 180' froggy oil, 1050#;
 5 1/2" 3642; CO 3647; swb 26 bf 8 hrs
 10% wtr; pmp 8 1/2 bo plus 9 bwpd from
 Arb 3642-47

COMPLETED

FABEN GI STRAP