

Section 35 Township 10 Range 18WWell No. #1 WilsonCompany Davis-Prime

			0					3

NORTH

WEST

EAST


SOUTH

Rooks

KANSAS ✓

Sec. 35 Twp. 10 R. 18WWell No. #1 Wilson FarmDavis-Prime CompanyPrime Drlg. ContractorNW Burnett Pool330 Ft. from N. Line Ft. from S. Line330 Ft. from E. Line Ft. from W. Line

NE NE NW

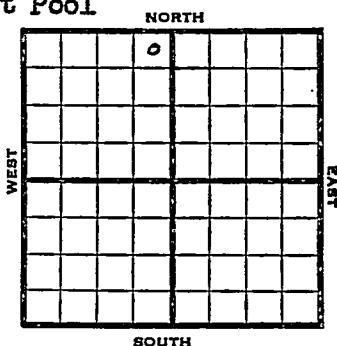

1953 Elev. 2118: REPORT

8/19 Spud 8-13-53
8" @ 185'
Drlg 2610'

8/26 Heeb 3328, Lans 3370
DST 3431-80 1 hr, 20' M 1180# Cong
3618
DST 3529-88 1 hr, 30' M
DST 3605-58 20 mins, 12' M, Simp 3699
Ero Arb 3712
RTD 3750'

9/2 Spud 8-13-53
D&A
TD 3750
8" @ 185'
Heeb 3328, Lans 3370
DST 3431-80, opn 1 hr., rec. 20' mud,
1180#
Cong 3618
DST 3529-88, opn 1 hr., rec. 30' mud
DST 3605-58, opn 20 mins., rec. 12'
mud
Simp 3699, Re-Arb 3712 ✓
TD 3750
D&A

ABANDONED

County Rooks State Kansas
 Sec. 35 (Blk.) 10 (Sur.) 18W Map No.
 Operator Davis-Prime
 Well No. 1 Farm Wilson
 Elev. _____ Location NE NE NW

FIRST REPORT

330 Ft. From N Line NW
330 Ft. From E Line Quarter

1st. Report AUG 19 1953

Completion

Remarks


Prime Drlg. - Contr.

Spudding Date 8-13-53

Drlg. Data NW Burnett Pool

8" @ 185 drlg. 2610

J. G. McGEHEE

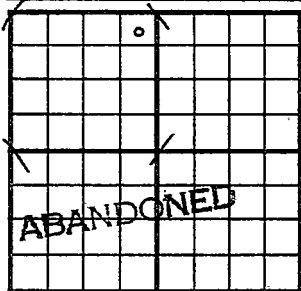County _____ Rocks _____ State KansasSec. 35 (Blk. 10) (Sur. 18W) (Twp. 18W) Map No. _____Operator Davis - PrimeWell No. 1 Farm WilsonElev. 2118 Location NE NE NW330 Ft. From N Line NW330 Ft. From E Line Quarter1st. ReportCompletion SEP 2 1953Remarks NW Burnett PoolPrime Drlg. - Contr.Spudding Date 8-13-53Drlg. Data D & A TD 37508" @ 185 Heeb. 3328 Lans. 3370DST 3431-80 open 1 hr. Rec. 20' mud1180# Cong. 3618 DST 3529-88open 1 hr. Rec. 30' mud DST 3605-58open 20 min. Rec. 12' mud Simp. 3699ReArb. 3712 TD 3750D & A