


Section 35 Township 10 Range 18W

Well No. #2 Wilson

Company Petroleum Inc.

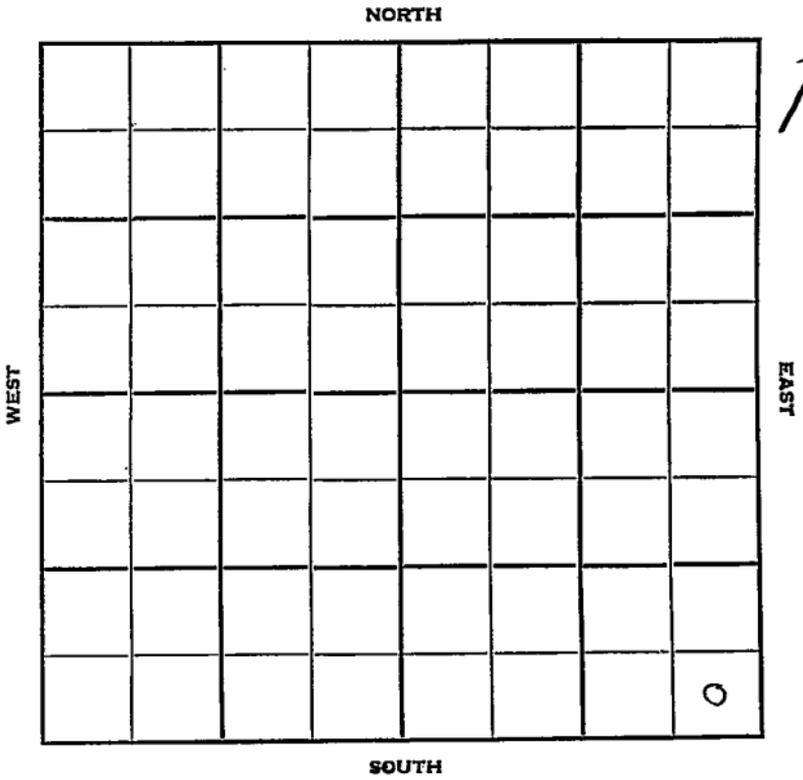

Sec. 35 Twp. _____ R. _____

Well No. # 2 Wilson Farm _____

Petroleum Inc. Company _____

Contractor _____

Burnett-NW


_____ Ft. from N. Line

330 Ft. from S. Line

330 Ft. from E. Line

_____ Ft. from W. Line

SE SE SE

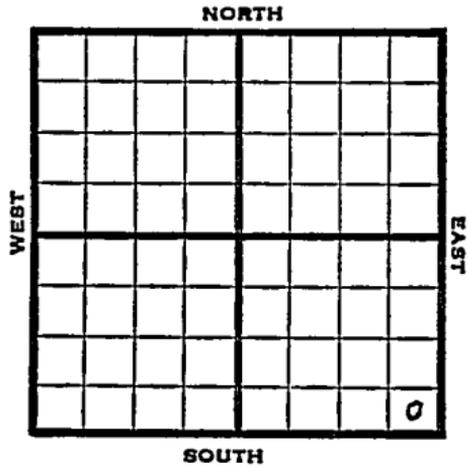

1952

Elev. 2060' REPORT

1/30

Spud 1-27-52
8" @ 241

Drlg. 1385'

2/6

8" @ 241' Heeb. 3252 Lans. 3294
Drlg. 3510'

2/13

DST 3273-3308, 3/4 hrs 75' mud
D.T 3332-82, 1 hr 20' m wtr
1100# BHP

DST 3446-96, 1 hr. 155' WCM
Arb. 3624 TD 3674 5" @ 3673
DP 3661 16/3623-25 150 A HFW
POP

2/20

P 1/4 BFPH 35% oil

3/5

No report

3/12

"

3/19

Spud 1-27-52

Oil Well

TD 3674

8" @ 241

Heeb. 3252

Lans. 3294

DST 3273-3308 open 3/4 hr. rec. 75' mud

DST 3332-82 open 1 hr. rec. 70' muddy

wtr. DST 3446-96 open 1 hr. rec. 155'

WCM Arb. 3624 TD 3674

5" @ 3673 DP to 3661 16/ 3623-25

150 A HFW P/ 1/4 bfph 35% oil

Comp. 46 bopd 60% wtr.

COMPLETED

