

Sec. 35

Twp.

R.

Well No. 2 Wilson "B" Farm

Sunray

Company

Burnett

990


Ft. from N. Line

Ft. from S. Line

330

Ft. from E. Line

Ft. from W. Line

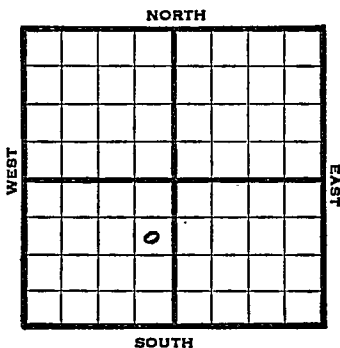

SE NE SW

1947

Elev. 2084' REPORT

4/30

Location

5/7

8" @ 1407'
Drlg. 2000'

5/13

Drlg. 2810'

5/21

Arb 3663
TD 3673'

ABANDONED

Map No. 64 Sec. 35 Twp. 10 R. 18W

Well No. 2 Wilson "B"

Sunray Company

FIRST REPORT

Contractor

SE NE SW


SECTION PLAT

990 Ft. from N. Line

 Ft. from S. Line

330 Ft. from E. Line

 Ft. from W. Line

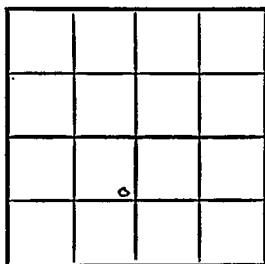

Rooks County

Location X

Rig up

Drilling and Remarks:

RECORD

Cased in., ft.

Sand

Gas

Oil

Total Depth

PRODUCTION

1st 24 hrs. Nat.

1st 24 hrs. after shot

Gas Cu. Ft.

Dry Hole

Abandoned

Date

APR 30 1947 19

S. J. LEWIS Scout

