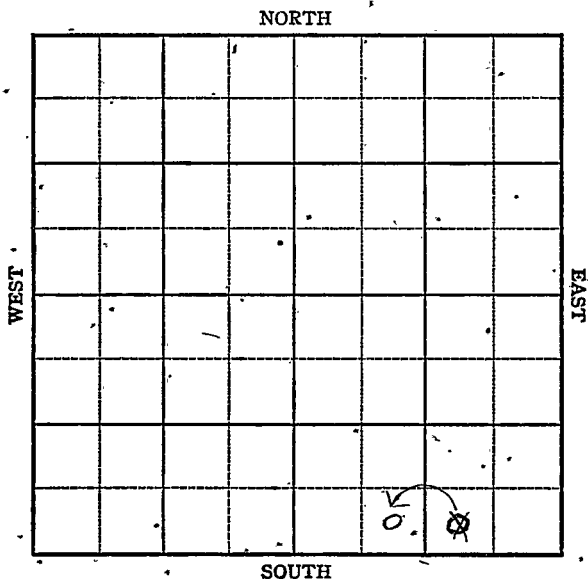


KANSAS

Rooks county

Section 35 Township 10 Range 18-WWell No. #1. WilsonCompany Sunray

Sec. 35 Twp. 10 R. 18W

Well No. 1 Wilson Farm

Sunray Company

Wildcat


 Ft. from N. Line

330 Ft. from S. Line

990 Ft. from E. Line

 Ft. from W. Line

~~SE SW SE~~
~~SW SE SE~~

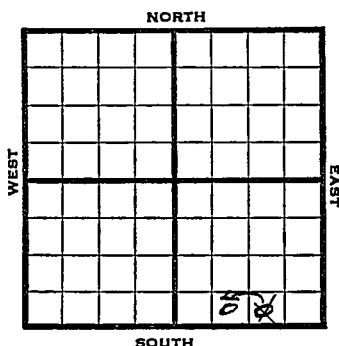

1947 Elev. 2047 REPORT

1/8 Surface Hole

1/15 Anhy 1357
8" @ 1365
Drlg 2625'

1/21 Lans 3294
BITC 3490
Cong 3510
Arb 3594-97
TD Sat.
5" @ 3595
RUST

1/30 SLM 3597
3600' TD
Simpson 3573
Arb 3597
5" @ 3598'
RUST

2/5 TD 3601
500 Acid
Swb 60 oil PH 3 hrs

2/12 " " "

OVER

2/19 Arb 3597
5" @ 3598
500 Acid
Echo Pot 3000
Grav. 30
TD 3601'

COMPLETED

Kansas

Map No. 64 Sec. 35 Twp. 10 R. 18WWell No. 1 WilsonSunray


Company

FIRST REPORT

Contractor

SW SE SE

SECTION PLAT

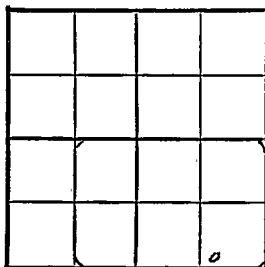 Ft. from N. Line330 Ft. from S. Line990 Ft. from E. Line Ft. from W. Line

Rooks County

Location Rig up

Drilling and Remarks:

surface hole

RECORD

Cased in., ft.Sand Gas Oil Total Depth

PRODUCTION

1st 24 hrs. Nat. 1st 24 hrs. after shot Gas Cu. Ft.Dry Hole Abandoned

Date

JAN 8 1947 19S. J. LEWIS Scout

Map No. 64 Sec. 35 Twp. 10 R. 18WWell No. 1 Wilson

Sunray


Company

CORRECTION

Contractor

SE SW SE

SECTION PLAT

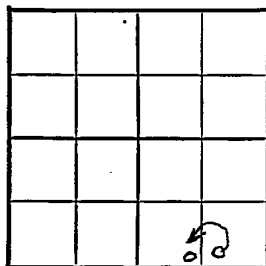 Ft. from N. Line330 Ft. from S. Line Ft. from E. Line990 Ft. from W. Line

Rooks County

Location Rig up

Drilling and Remarks:

Reported

SW SE SE

RECORD

Cased in., ft.Sand Gas Oil Total Depth

PRODUCTION

1st 24 hrs. Nat. 1st 24 hrs. after shot Gas Cu. Ft.Dry Hole Abandoned

Date

Jan 15 1947 19

S. J. LEWIS

Scout

Map No. 104 Sec. 35 Twp. 10 R. 18W

Well No. 1 Wilson

Sunray Company

COMPLETE

Contractor

SE SW SE


E1.2047
SECTION PLAT

 Ft. from N. Line

330 Ft. from S. Line

 Ft. from E. Line

990 Ft. from W. Line

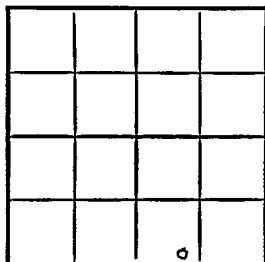

Rooks County

Location

Rig up

Drilling and Remarks:

Per X 3597

5" @ 3598

5000 cu ft

Echid Per 3000

30° S

RECORD

Cased in., ft.

Sand

Gas

Oil

Total Depth 3601

PRODUCTION

1st 24 hrs. Nat.

1st 24 hrs. after shot

Gas Cu. Ft.

Dry Hole

Abandoned

Date

FEB 19 1947

S. J. LEWIS

Scout