


Section 35 Township 10 Range 19W

Well No. 2 Casey

Company Veeder Supply

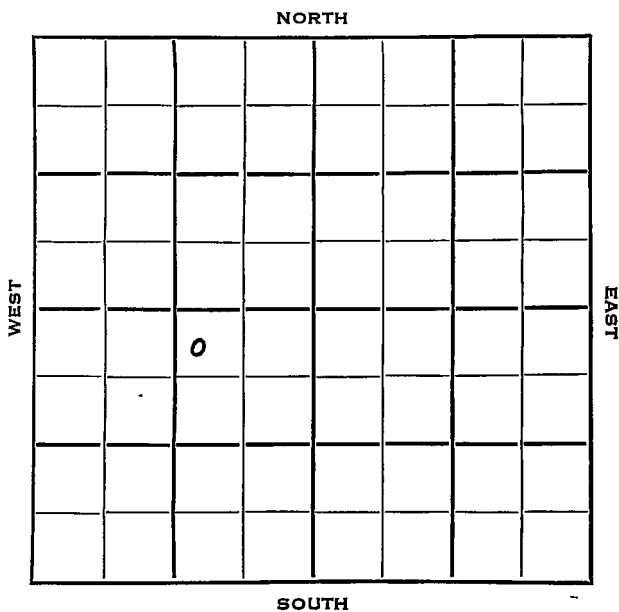

Rooks

KANSAS


SEC.	TWP.	R.
35	10	19W ✓

WELL NO. #2 Casey FARM

COMPANY Veeder Supply

CONTRACTOR Veeder Supply  
McCulley Pool

330 Ft. from N. Line  
Ft. from S. Line  
1150 Ft. from E. Line  
Ft. from W. Line

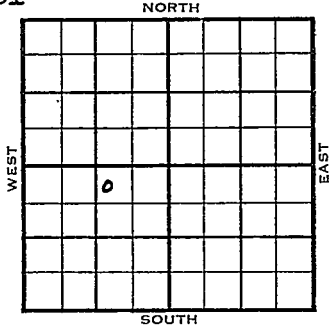

NW NE SW

1954	ELEVATION 2128'	REPORT
------	-----------------	--------

4/14 Spud 4-8-54  
8" @ 146'  
Anhy 1470'  
Dr1g 2980'

6/23 NR

6/30 Spudding 4-8-54  
Oil well  
TD 3646  
8" @ 146  
Anhy 1470 Top 3062 Heeb 3279 Lans. 332  
3321  
DST 3471-3517 open 1 hr. Rec 30' mud  
SSO off  
Cong 3568 Simp 3610 Arb. 3641  
TD 3646  
5" @ 3642 CO to 3613 12/ 3519-23  
24/ 3508-16 2500 A 24/ 3473-94  
2500 A 2 1/2 boph 30% wtr. Comp 35 bopd  
50% wtr.

COMPLETED



County \_\_\_\_\_ Rocks \_\_\_\_\_ State **Kansas**

Sec. **35** (Blk. Twp.) **10** (Sur. Rge.) **19W** Map No. \_\_\_\_\_

Operator **Veeder Supply**

Well No. **2** Farm **Casey**

Elev. **2128** Location **NW NE SW**


330 Ft. From **N** Line **SW**

1150 Ft. From **E** Line **Quarter**

1st. Report \_\_\_\_\_

Completion **JUN 30 1954**

Remarks **McCulley Pool**

**Veeder Supply - Contr.**

Spudding Date **4-8-54**

**COMPLETE**

Drlg. Data **Oil well** **TD 3646**

**8" @ 146 Anhy 1470 Top. 3062**

**Heeb. 3279 Lans. 3321 DST 3471-3517**

**open 1 hr. Rec. 30' mud SSO O#**

**Cong. 3568 Simp. 3610 Arb. 3641**

**TD 3646 5" @ 3642 CO to 3613**

**12/ 3519-23 24/ 3508-16 2500 A**

**24/ 3473-94 2500 A 2 1/2 boph 30% wtr.**

**Comp. 35 bopd 50% wtr.**