


Section 35 Township 10 Range 19W

Well No. 2 McCollough

Company Veeder Supply

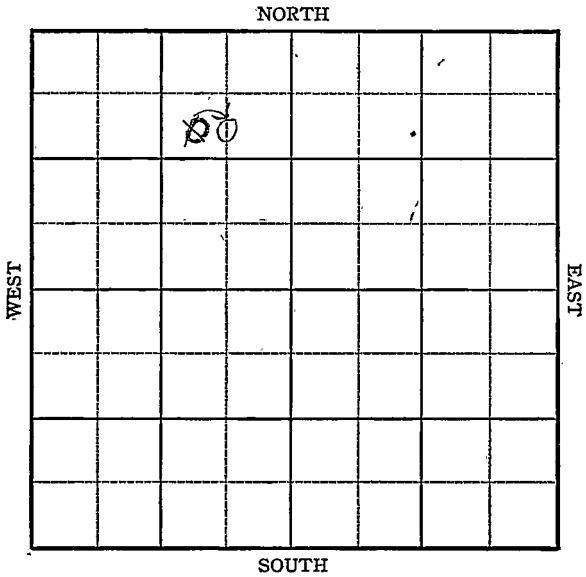

Sec. 35 Twp. _____ R. 10 19W

Well No. 2 McCullough Farm _____

Weeder Supply Company _____

Zur ick


990 Ft. from N. Line

_____ Ft. from S. Line

660

~~990~~ Ft. from E. Line

_____ Ft. from W. Line

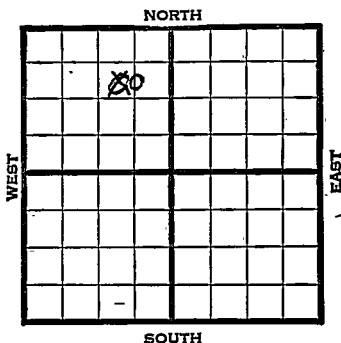

~~SW NE NW~~ CSL NE NW

1945

Elev. 2113 REPORT

6/27

Location

~~8/3~~

Location

7/11

12" @ 95' WOC

7/19

" " "

7/26

Drlg. 370

8/1

Lans 3285

TD 3541

5" @ 3539' RUST

8/8

35 shots 3502-3514

100' fluid 1/2 hr. 35% oil

8/15

" " " " "

8/22

Swab 5 oil per hr.

8/29

Lans 3285

5" @ 3539

Perf.

TD 3541'

Pump 75 Pot.

Grav. 32.0

COMPLETED

Kansas Pool Name ZurickMap No. 65 Sec. 35 Twp. 10 R. 19WWell No. 2 McCulloughVeeder Supply CompanyFIRST REPORT Contractor

SW NE NW

SECTION PLAT

990 Ft. from N. Line Ft. from S. Line990 Ft. from E. Line Ft. from W. Line

	0		

Rooks CountyLocation XRig up

Drilling and Remarks:

RECORD

Cased in., ft.Sand Gas Oil Total Depth

PRODUCTION

1st 24 hrs. Nat. 1st 24 hrs. after shot Gas Cu. Ft.Dry Hole Abandoned

Date

JUN 27 1945 19S. J. LEWIS Scout

Kansas Pool Name Zurick

Map No. 65 Sec. 35 Twp. 10 R. 19W

Well No. 2 McCullough

Veeder Supply Company

CORRECTION

Contractor

C S L NE NW

SECTION PLAT

	o		

990 Ft. from N. Line

 Ft. from S. Line

660 Ft. from E. Line

 Ft. from W. Line

Rooks County

Location

Rig up

Drilling and Remarks:

reported SW NE NW

RECORD

Cased in., ft.

Sand

Gas

Oil

Total Depth

PRODUCTION

1st 24 hrs. Nat.

1st 24 hrs. after shot

Gas Cu. Ft.

Dry Hole

Abandoned

Date

JUL 1 1 1945

19

S. J. LEWIS

Scout

KANSAS Kansas Pool Name Zurick

Map No. 65 Sec. 35 Twp. 10 R. 19W

Well No. 2 McCullough

Veeder Supply Company

COMPLETED Contractor

C S L NE NW

E 1 2 1 0
SECTION PLAT

990 Ft. from N. Line

_____ Ft. from S. Line

660 Ft. from E. Line

_____ Ft. from W. Line

Rooks County

RECORD

Location _____

Rig up _____

Drilling and Remarks:

Loss 325'

5' @ 53'

Peey.

Prod 75 P.Y.

32° E

Cased _____ in., _____ ft.

Sand _____

Gas _____

Oil _____

Total Depth 3541

PRODUCTION

1st 24 hrs. Nat. _____

1st 24 hrs. after shot _____

Gas _____ Cu. Ft.

Dry Hole _____

Abandoned _____

Date

AUG 29 1945

19

S. J. LEWIS

Scout