


Section 35 Township 10 Range 19-W

Well Number 1 McCollugh

Company Green Oil

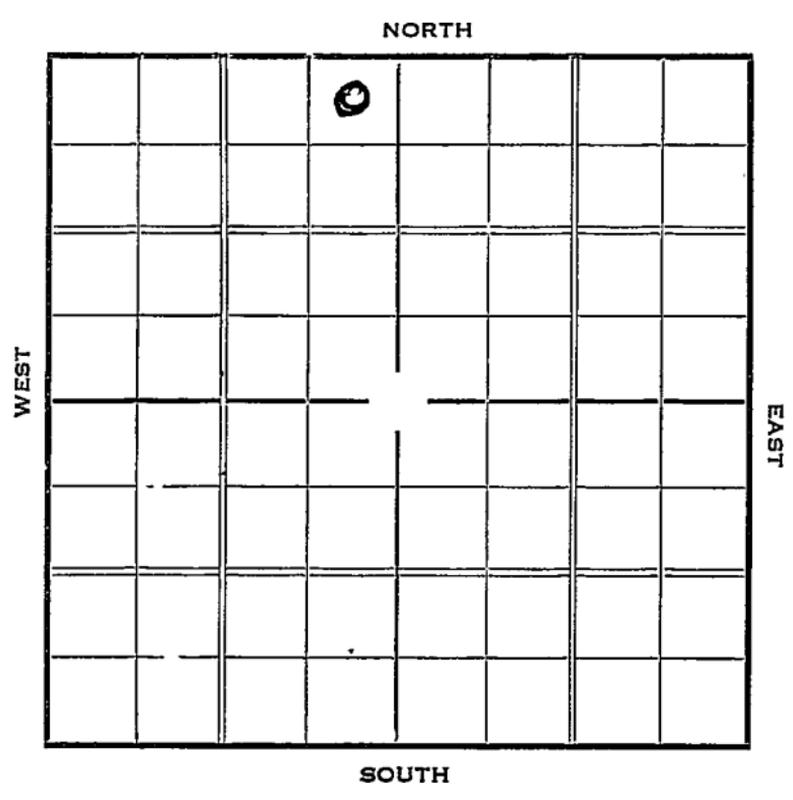



Sec. 35 Twp. 10 R. 19-W


Well No. #1 McCollugh Farm  
Green Oil Company

330 Ft. from N. Line

\_\_\_\_\_ Ft. from S. Line

330 Ft. from E. Line

\_\_\_\_\_ Ft. from W. Line

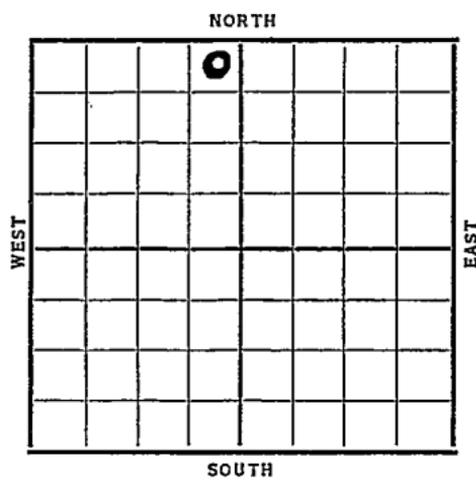

## Special

Date	Elev. 2104	REPORT
1937		
3/24		Logation
4/2		Rig
4/8		Rigging up
4/16		Spud
4/23		Fishing 510'.
4/30		Drlg. 565'.
5/7		12" @ 625'. Drlg. 750'.
5/14		Drlg. 1110'.
5/21		Drlg. 1250'.
5/28		SD 1370'.
6/4	" "	
6/11	" "	
6/19	" "	
6/25	" "	
7/2	" "	
7/9	" "	
7/16		10" @ 1070'. U. R.
7/22		10" @ 1420'. Drlg. 1430'.
7/30		Drlg. 1880'.
8/6		T.D. 2380' SD.
8/13	" "	

### OVER

1937

8/20 SD 2380'.  
8/28 " "  
9/3 " "  
9/10 " "  
9/17 " "  
9/24 " "  
10/2 " "  
10/8 " "  
10/15 " "  
10/22 " "  
10/29 " "  
11/5 " "  
11/12 " "  
11/19 " "  
11/26 " "  
12/3 " "  
12/10 8" @ 2385'.  
Clean out.  
12/17 8" @ 2407'.  
Drlg. 2505'.  
12/24 8" @ 2520'. C.O.  
12/30 T.D. 2677'.

1938

1/7 T.D. 2760'. U. R. 8".  
1/14 " " " "  
1/20 Shut down  
1/28 8"-2787' C.O. @ 2850'.  
2/4 8" - 2879' Drlg. 2910'

OVER

1938

2/11 8" @ 2912', T.D. 3015'.  
U. R. 8".

2/18 " " " "

2/25 " " " "

3/4 8" @ 3045'. S.O./ 3059 & 3098'.  
4 B.W. 3114-25'. Drlg. 3228'.

3/11 8" @ 3226'. S.O. 3275-79 &  
3397-3304'. At 3330-33 Est. 7  
bbls. oil per day. & 1/2 BWPB.  
K.C. 3297'. T.D. 3335'.  
Testing.

3/18 1/2 B.W. 3333-35'.  
S.O. 3355-59'. 9 bailers oil  
in 2 hrs. 3488-98'.  
T.D. 3504'. 8" @ 3402'.  
Cleaning out.

3/25 8" @ 3425'. WOC.

4/1 T.D. 3513'. 250' oil in 1 1/2 days  
Cleaning out.

4/8 Pulling big pipe.

4/15 " " "

4/22 " " "

4/29 2000 acid. Swab 15 oil per hour  
for 16 hours.

5/6 P.B. 3508'. 8000 acid.

5/12 " " " "

5/20 " " " "

5/27 Pump 140 oil in 8 hrs.

6/3 Testing.

OVER



1938

6/8 8" - 3425' .  
K. C. 3297' .  
T. D. 3513' .  
P. B. 3505' .  
10,000 acid.     .  
Potential 1050 bbls.  
Gravity 33/78

COMPLETED

2104

Map No. 65 Sec. 35 Twp. 10 R. 19W.

Well No. 1 Mc Collough.

Green Oil Company

Contractor

**Special**

**SECTION PLAT**

		0		

320 Ft. from N. Line

\_\_\_\_\_ Ft. from S. Line

330 Ft. from E. Line

\_\_\_\_\_ Ft. from W. Line

**FIRST REPORT**

Location ✓

Rig up \_\_\_\_\_

Drilling and Remarks:

**RECORD**

Cased \_\_\_\_\_ in., \_\_\_\_\_ ft.

Sand \_\_\_\_\_

Gas \_\_\_\_\_

Oil \_\_\_\_\_

Total Depth \_\_\_\_\_

**PRODUCTION**

1st 24 hrs. Nat. \_\_\_\_\_

1st 24 hrs. after shot \_\_\_\_\_

Gas \_\_\_\_\_ Cu. Ft.

Dry Hole \_\_\_\_\_

Abandoned \_\_\_\_\_

Date

MAR 24 1937 19

S. J. LEWIS Scout

Map No. 65 Sec. 35 Twp. 10 R. 19W

Well No. 1 McCullough

Green Oil

Company

Contractor

**COMPLETED**

NE NW

330 Ft. from N. Line

\_\_\_\_\_ Ft. from S. Line

330 Ft. from E. Line

\_\_\_\_\_ Ft. from W. Line

**SECTION PLAT**

	0		

Location \_\_\_\_\_

Rig up \_\_\_\_\_

Drilling and Remarks:

*P.B. 3505*  
*10,000 Acid*  
*POT 1050*  
*grav. 33/78*

**RECORD**

Cased 8 in., 3425 Ft.

Sand KC 3297

Gas \_\_\_\_\_

Oil \_\_\_\_\_

Total Depth 3513

**PRODUCTION**

1st 24 hrs. Nat. \_\_\_\_\_

1st 24 hrs. after shot \_\_\_\_\_

Gas \_\_\_\_\_ Cu. Ft.

Dry Hole \_\_\_\_\_

Abandoned \_\_\_\_\_

Date

JUN 8 - 1938

19

H. D. Hatfield Scout