


Section 35 Township 10 Range 20WWell No. #1 ArmbristerCompany Cities Service Oil

NORTH

WEST

EAST

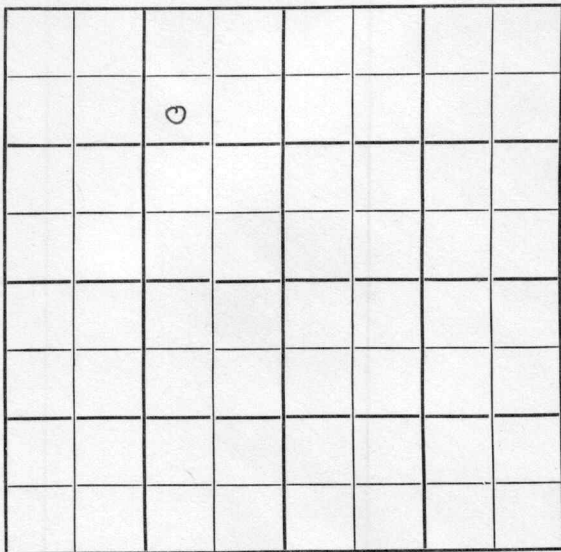

SOUTH



Sec. 35 Twp. 10 R. 20W

Well No. #1 Armbrister Farm

Cities Service Oil Company

Contractor


990' Ft. from N. Line

Ft. from S. Line

990' Ft. from E. Line

Ft. from W. Line

SW NE NW

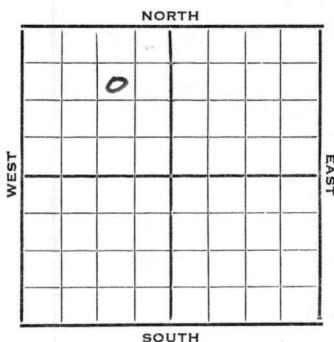

1952 Elev. 2160' REPORT

9/17 Location

9/24 8" @ 244
Drlg. 2630'

10/1 Heeb 3391, Dodge 3419, Lans 3435
DST 3512-20, 1 hr., 600' SW 1180# 15"
Cherty Cong 3680, Simp shale 3718,
Simp Dol 3727, Arb 3741
RTD 3742
5" @ 3742

10/15 Spud 9-17-52
Oil Well TD 3748'
8" @ 244'

Heeb. 3397 Dodge 3419
Lans. 3435
DST 3512-20 open 1 hr. rec. 600' SW
1180#
Cong. 3680 Simp. sh 3718
Simp. dol. 3727 Arb. 3741
TD 3742 5" @ 3742 DD 3748
FU 240 go 12 hr. 1000 A
2500 A Comp. 78 bopd 2 bw

COMPLETED

Rooks

State KANSAS

35

(Blk.)
(Twp.)

10

(Sur.)
(Rge.)

20W

Map No.

Cities Service Oil

1

Farm

Armbrister

Elev.

Location

SW NE NW

A grid with a diagonal line and the text "FIRST REPORT". The grid is composed of small squares. A diagonal line runs from the bottom-left towards the top-right. The words "FIRST REPORT" are written in a bold, sans-serif font, following the path of the diagonal line. The word "FIRST" is on the left, and "REPORT" is on the right. There are some small, dark marks on the grid, possibly ink or dust.

990

Ft. From **N**

Line

NEW

990

Ft. From **E**

Line

Quarter

1st Report

SEP 17 1952

Completion

Remarks

Spudding Date

Drlg. Data

Location


J. G. McGEHEE

County _____ Rocks _____ State Kansas
 Sec. 35 (Blk. 10) (Sur. 20W) Map No. _____
 (Twp. _____) (Rge. _____)

Operator Cities Service Oil

Well No. 1 Farm Armbrister

Elev. 2160 Location SW NE NW

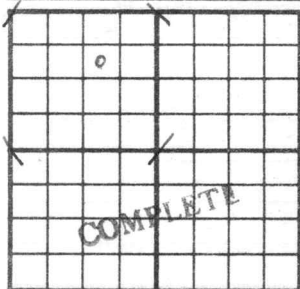

990 Ft. From N Line NW

990 Ft. From E Line Quarter

1st. Report

OCT 15 1952

Completion

Remarks

Spudding Date 9-17-52

Drilg. Data Oil well TD 3748

8" @ 244 Heeb. 3397 Dodge 3419

Lans. 3435 DST 3512-20 open 1 hr.

Rec. 600' sw 1180# Cong. 3680

Simp. sh. 3718 Simp. dol. 3727

Arb. 3741 TD 3742 5" @ 3742

DD 3748 FU 240 go 12 hr. 1000 A

2500 A Comp. 78 bopd 2 bw

J. G. McGEHEE