

Section 35 Township 10 Range 20W

Well No. 1 Teall

Company Mid-States Oil Corp.

NORTH

				0			

WEST

EAST

SOUTH

Rooks

KANSAS

Sec. 35 Twp. 10 R. 20 W ✓

Well No. # 1 Teall Farm

Mid-States Oil Corp. Company

Barnett Drlg. Contractor

Semi-Wildcat


330 Ft. from N. Line

_____ Ft. from S. Line

_____ Ft. from E. Line

330 Ft. from W. Line

NW NW NE

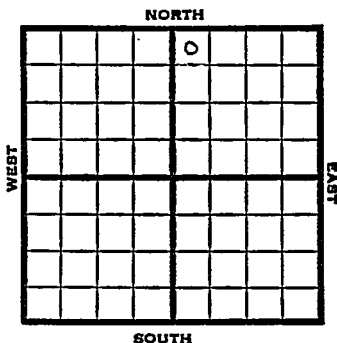

1951 Elev. 2195' REPORT

8/1 Location

10/10 Spud 8-14-51
 Oil Well TD 3779
 8" @ 141
 Anhy 1625 Top. 3219
 Heeb. 3431 Dodge. 3451
 Lans. 3467
 DST 3501-16 opn 1½ hr. Rec. 93' wtr
 DST 3537-54 opn ½ hr. Rec. 15' socm
 Cong. 3717 Simp 3756
 Arb. 3774
 Clred 3776-79 Rec. 2½' dol. w/so
 DST 3775-79 opn ½ hr. Rec. 5' hocm
 10' ocm TD 3779 5" @ 3774½
 B/10 goph 500 A B/2½ boph 24 hr.
 P/48 bo 20 hr Comp. 50 bopd.

COMPLETED

County Rooks State Kansas

Sec. 35 (^{Blk.}Twp.) 10 (^{Sur.}Rge.) 20W Map No.

Operator Mid-States Oil Corp.

Well No. 1 Farm Teall

Elev. _____ Location NW NW NE

		10		

330 Ft. From N Line NE

330 Ft. From W Line Quarter

1st. Report AUG 1 1951

Completion

Remarks

Barnett Drlg. - Contr.

Spudding Date

Drlg. Data Semi Wildcat

Location

J. E. TYRA

County _____ Rocks _____ State KansasSec. 35 (Blk. Twp.) 10 (Sur. Rge.) 20W Map No. _____Operator Mid-States Oil Corp.Well No. 1 Farm TeallElev. 2195 Location NW NW NE

330 Ft. From N Line NE330 Ft. From W Line Quarter

1st. Report _____

Completion OCT 10 1951Remarks Semi WildcatBarnett Drlg. - Contr.Spudding Date 8-14-51Drlg. Data Oil well TD 37798" @ 141 Anhy 1625 Top. 3219Heeb. 3431 Dodge 3451 Lans. 3467DST 3501-16 open 1½ hr. Rec. 93' waterDST 3537-54 open ½ hr. Rec. 15' socmCong. 3717 Simp. 3756 Arb. 3774Cored 3776-79 Rec. 2½' dol. w/ SODST 3775-79 open ½ hr. Rec. 5' hocm10' ocm TD 3779 5" @ 3774½ B/ 10 goph500 A B/ 2½ boph 24 hr. P/ 48 bo 20 hr.Comp. 50 bopd