

KANSAS

Section 35 Township 10 Range 20WWell No. #1 TeallCompany Champlin Refg.

NORTH

WEST

EAST

SOUTH

Rooks

KANSAS

Sec. 35 Twp. 10 R. 20W ✓

Well No. #1 Teall Farm

Champlin Ref. Company

Champlin Contractor

Wildcat

 Ft. from N. Line

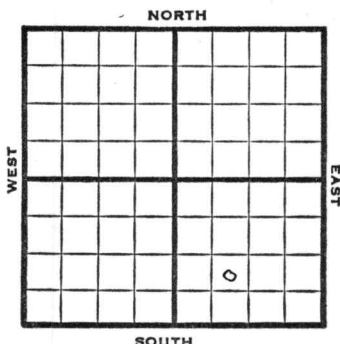
990 Ft. from S. Line

 Ft. from E. Line

990

 Ft. from W. Line

NE SW SE



1951

Elev. 2157' REPORT

11/21

Spud 11-18-51

10" @ 151

Drlg. 500'

12/5

Spud 11-18-51

D&A TD 3920

10" @ 151'

Anhy 1580 Heeb. 3422

Tor. 3444 Lans. 3460

DST 3485-3515 open $\frac{1}{2}$ hr.

Rec. 30' wtr. & mud

DST 3606-35 open $\frac{1}{2}$ hr.

Rec. 35' mud

DST 3640-73 open 1 hr.

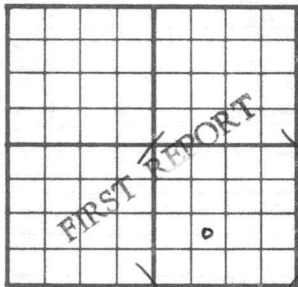
Rec. 780' wtr.

B KC 3677 Cong. 3733

Arb. 3852-3920 TD

D&A

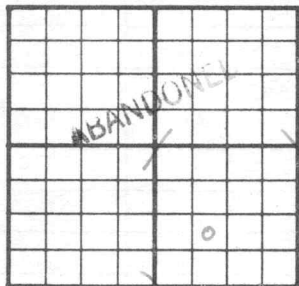
ABANDONED

County **Rooks** State **Kansas**Sec. **35** (Blk. Twp.) **10** (Sur. Rge.) **20W** Map No.Operator **Champlin Ref.**Well No. **1** Farm **Teall**Elev. Location **NE SW SE****990** Ft. From **S** Line **SE****990** Ft. From **W** Line Quarter1st. Report **NOV 21 1951**

Completion

Remarks

Champlin - Contr.Spudding Date **11-18-51**Drlg. Data **Wildcat****10" @ 151 drlg. 500**

County Rocks State KansasSec. 35 (Blk. Twp.) 10 (Sur. Rge.) 20W Map No. Operator Champlin Ref.Well No. 1 Farm TeallElev. 2157 Location N E SW SE990 Ft. From S Line SE990 Ft. From W Line Quarter1st. Report Completion DEC 5 1951Remarks WildcatChamplin Ref. - Contr.Spudding Date 11-18-51Drlg. Data D & A TD 392010" @ 151 Anhy 1580 Heeb. 3422Tor. 3444 Lans. 3460 DST 3485-3515open ½ hr. Rec. 30' water & mudDST 3606-35 open ½ hr. Rec. 35' mudDST 3640-73 open 1 hr. Rec. 780' waterB KC 3677 Cong. 3733 Arb. 3852-3920 TDD & A

J. E. TYRA