


Section 35 Township 10 Range 20WWell No. #1 R. E. TeallCompany Gulf

NORTH

WEST

EAST

SOUTH

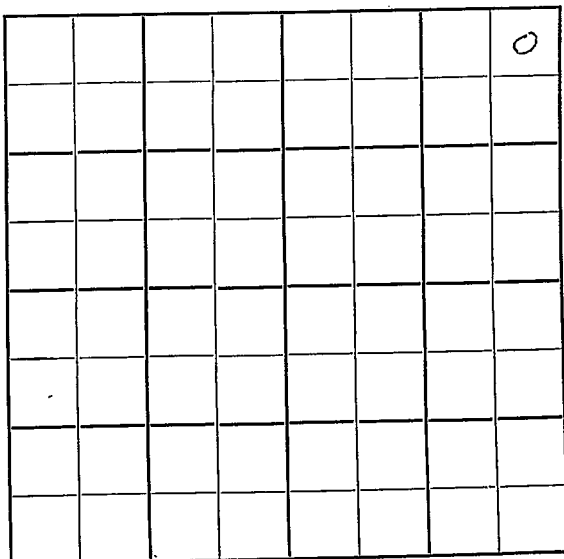

KANSAS Rooks

Sec. 35 Twp. 10 R. 20-W

Well No. #1 R E Teall Farm

Gulf

Company

Contractor


330 Ft. from N. Line

Ft. from S. Line

330 Ft. from E. Line

Ft. from W. Line

NE NE NE

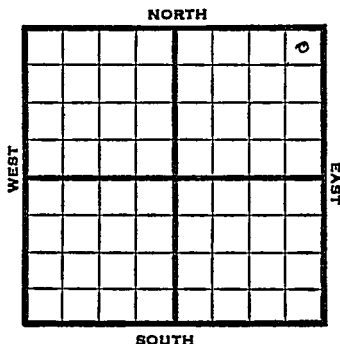

1950

Elev 2167'

REPORT

2/1

Spud 1-30-50

Drlg

2/15

TD 3913'

8" @ 1608'

Anhy 1600'

Heeb 3408'

Tor 3433'

Lans 3447'

Cong 3755'

Arb. 3901'

D&A

Aband.

ABANDONED

Kansas

Berland SW

Map No. _____ Sec. 35 Twp. 10 R. 2 OW

Well No. 1 R. E. Teall

Gulf _____ Company

Contractor

NE NE NE


SECTION PLAT

330 Ft. from N. Line .

_____ Ft. from S. Line

330 Ft. from E. Line

_____ Ft. from W. Line

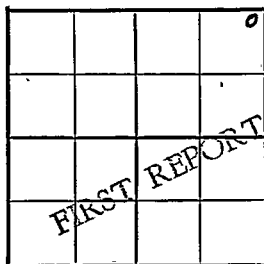

Rooks County

Location _____

Rig up _____

Drilling and Remarks:

Spud 1-30-50

drlg.

RECORD

Cased _____ in., _____ ft.

Sand _____

Gas _____

Oil _____

Total Depth _____

PRODUCTION

1st 24 hrs. Nat. _____

1st 24 hrs. after shot _____

Gas _____ Cu. Ft.

Dry Hole _____

Abandoned _____

Date

FEB 1 1950

19

J. E. TYRA Scout

Kansas


Map No. _____ Sec. 35 Twp. 10 R. 20thWell No. 1 R. E. Teall

Gulf

Company

Contractor

NE NE NE

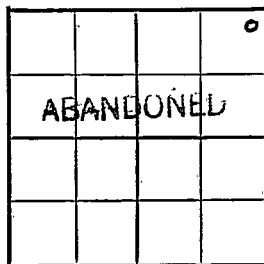E. 2167
SECTION PLAT330 Ft. from N. Line

_____ Ft. from S. Line

330 Ft. from E. Line

_____ Ft. from W. Line

Rooks County

Location _____

Rig up _____

Drilling and Remarks:

8" @ 1608

ank 1600

keel 3408

Jor 3433

Lans 3447

Cong 3755

ank 3901

RECORD

Cased _____ in., _____ ft.

Sand _____

Gas _____

Oil _____

Total Depth 3913

PRODUCTION

1st 24 hrs. Nat. _____

1st 24 hrs. after shot _____

Gas _____ Cu. Ft.

Dry Hole _____

Abandoned _____

Date

D & A.

FEB 15 1950

19

J. E. TYRA

Scout