

Graham


FORM 51

KANCAS

Section 35 Township 10 Range 21W

Well No. #2 Lewis "A"

Company Harry Gore

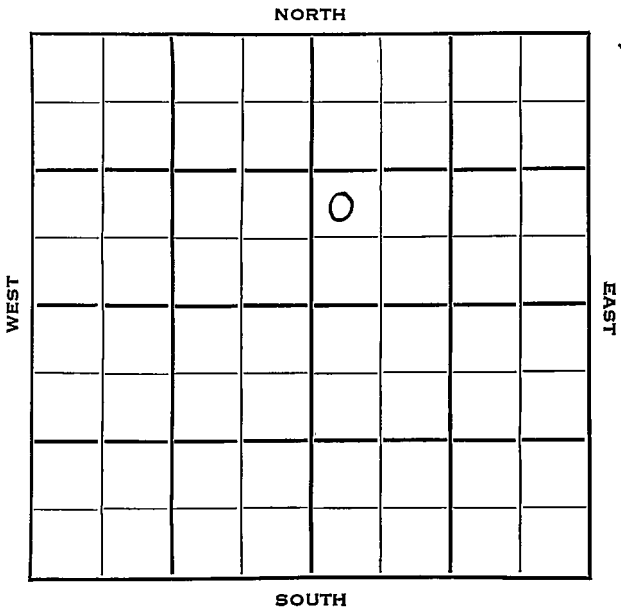

Graham

KANSAS

SEC.	TWP.	R.
35	10	21 W

WELL NO.

2 Lewis "A"

FARM

COMPANY

Harry Gore

CONTRACTOR

Veeder

SW White Pool


_____ Ft. from N. Line

990 _____ Ft. from S. Line

_____ Ft. from E. Line

330 _____ Ft. from W. Line

NW SW NE

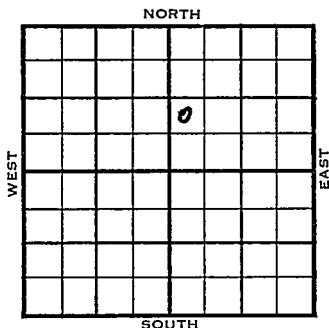

1953

ELEVATION

2105'

REPORT

10/7

MIR

10/14

8" @ 215' w/125 sks

Anhy 1560', Top 3130', Heeb 3339',

Tor 3361', Lans 3378'

Drilg. 3434'

10/21

Arb. 3678'

RTD 3685'

5" @ 3682'

10/28

CO 3685' FU 1500' oil 1 hr, 3200'

oil 3 hrs.

11/4

Spud 10-6-53 Oil well TD 3685'

8" @ 215' Anhy 1560' Top 3130'

Heeb 3339' Tor. 3361' Lans 3378'

Arb. 3678' TD 3685' 5" @ 3682'

CO to 3685' FU 1500' oil 1 hr.

3200' 1 hr.

Comp. 1181 BOPD

COMPLETED

County Graham State Kansas

Sec. 35 (Blk. Twp.) 10 (Sur. Rge.) 21W Map No.

Operator Harry Gore

Well No. 2 Farm Lewis "A"

Elev. _____ Location NW SW NE

990 Ft. From S Line NE

330 Ft. From W Line Quarter

Ist. Report OCT 7 1953

Completion _____

Remarks _____

Veeder - Contr.

Spudding Date _____

Drlg. Data SW White Pool

M I R

