


Graham

KANSAS

Section 35 Township 10 Range 21W

Well No. 1 Lewis "C"

Company H. Gore & Stanolind

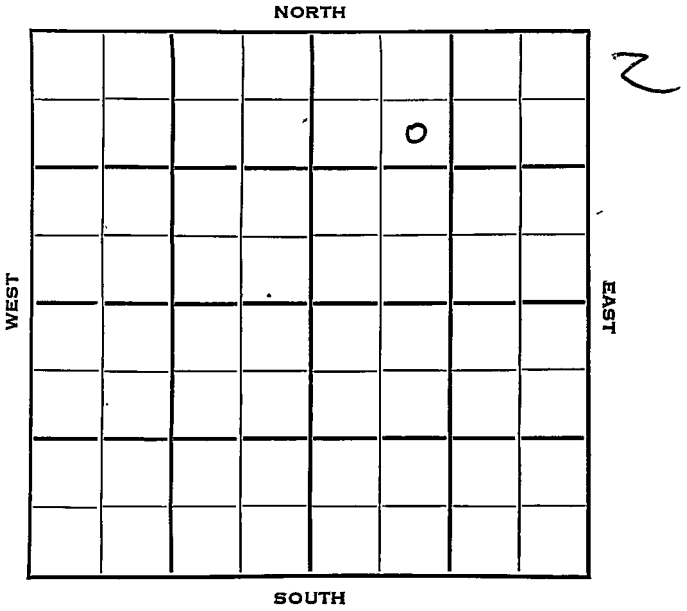



Sec. 35 Twp. 10 R. 21 W

Well No. # 1 Lewis "C" Farm

H. Gore & Stanolind Company

Veeder Contractor


990 Ft. from N. Line

Ft. from S. Line

Ft. from E. Line

990 Ft. from W. Line

SE NW NE

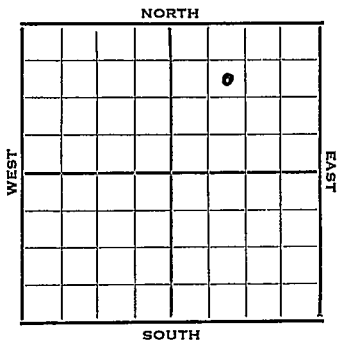

1953

Elev. 2136'

REPORT

7/29

Spud 7-21-53
8" @ 210 Anhy 1594'
Drlg. 3418'

8/5

Top 3161, Heeb 3368, Lans 3414
DST 3473-93, 1 hr., 20' ocm, 610' sw,
1410#
Arb 3700
DST 3701-06, 3/4 hrs., 470' gas, 1130'
free oil, 30' ocm, 1060#
RTD 3706
5" @ 3702'

8/12

Spud 7-21-53 Oil well TD 3706
8" @ 210 Anhy 1594' Top. 3161
Heeb 3368 Lans 3414
DST 3473-93 open 1 hr rec 20' OCM
610' SOGW 1410# Arb. 3700
DST 3701-06 open 3/4 hr rec 470' gas
1130' free oil, 30' OCM 1060#
TD 3706 5" @ 3702 CO to 3706
FU 1630' oil 25 min P/18 BOPH
Comp. 3000 BOPD

COMPLETED

County Graham State Kansas

Sec. 35 (Blk. Twp.) 10 (Sur. Rge.) 21W Map No.

Operator H. Gore & Stanolind

Well No. 1 Farm Lewis "C"

Elev. 2136 Location SE NW NE

			0		

990 Ft. From N Line NE

990 Ft. From W Line Quarter

1st. Report JUL 29 1953

Completion

Remarks

Veeder - Contr.

Spudding Date 7-21-53

Drlg. Data

8" @ 210 Anhy 1594 drlg. 3418

