


Section 35 Township 10 Range 21W

Well No. #2 Lewis "C"

Company Gore & Stanolind

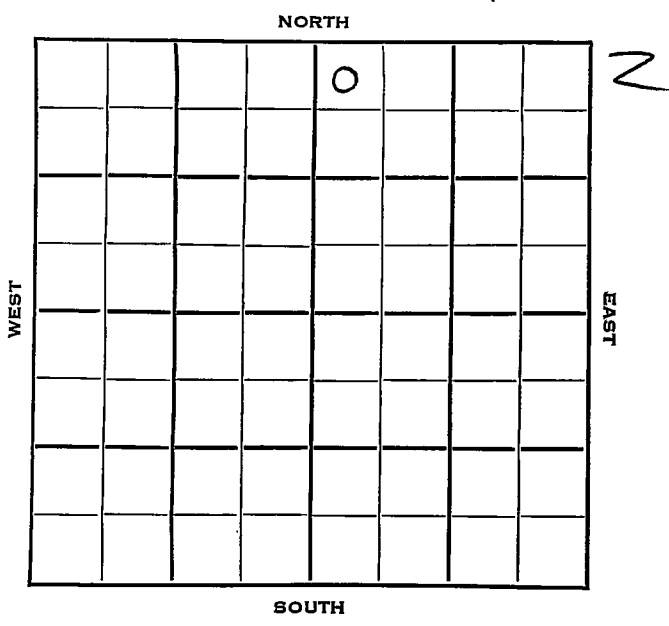

Sec. 35 Twp. 10 R. 21W

Well No. #2 Lewis "C" Farm

Gore & Stanolind

Company

Veeder

Contractor

SW White Pool


330 Ft. from N. Line

\_\_\_\_\_ Ft. from S. Line

\_\_\_\_\_ Ft. from E. Line

330 Ft. from W. Line

NW NW NE

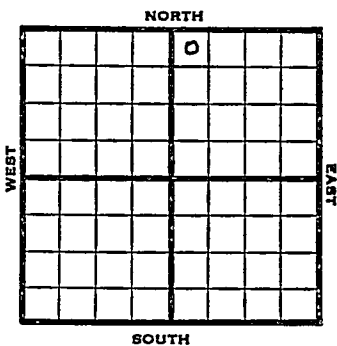

1953

Elev. 2114'

REPORT

8/19

Spud 8-15-53

8" @ 210'

Anhy 1580'

Drlg 1880'

8/26

Lang 3409, Cong 3675, Arb 3703

DST 3704-10 failed.

Drlg 3710'

9/2

Spud 8-15-53

D&A

TD 3760

8" @210

Anhy 1580, Lang 3409, Cong 3675,

Arb. 3703

DST 3704-10, failed

TD 3760

D&A

**ABANDONED**

County Graham State Kansas

Sec. 35 (Blk. 10) (Sur. Rge.) 2 W Map No.

Operator Gore & Stanolind

Well No. 2 Farm Lewis "C"

Elev. Location NW NW NE

			0		
FIRST REPORT					

330 Ft. From N Line N

330 Ft. From W Line Quarter

Ist. Report AUG 19 1953

Completion

Remarks

Veeder - Contr.

Spudding Date 8-15-53

Drlg. Data SW White Pool

8" @ 210 Anhy. 1580 drlg. 1880

County Graham State Kansas

Sec. 35 (Blk. 10) (Sur. 21W) (Twp. 10) (Rge. 21W) Map No.

Operator Gore & Standlind

Well No. 2 Farm Lewis "C"

Elev. 2114 Location NW NWNE


330 Ft. From N Line NE

330 Ft. From W Line Quarter

1st. Report

Completion SEP 2 1953

Remarks SW White Pool

Veeder - Cntr.

Spudding Date 8-15-53

Drlg. Data D & A TD 3760

8" @ 210 Anhy 1580 Lens. 3409

Cong. 3675 Arb. 3703 DST 3704-10

failed TD 3760

D & A