


Section 35 Township 10 Range 21W

Well No. #2 Lewis

Company Ted Gore & Stanolind

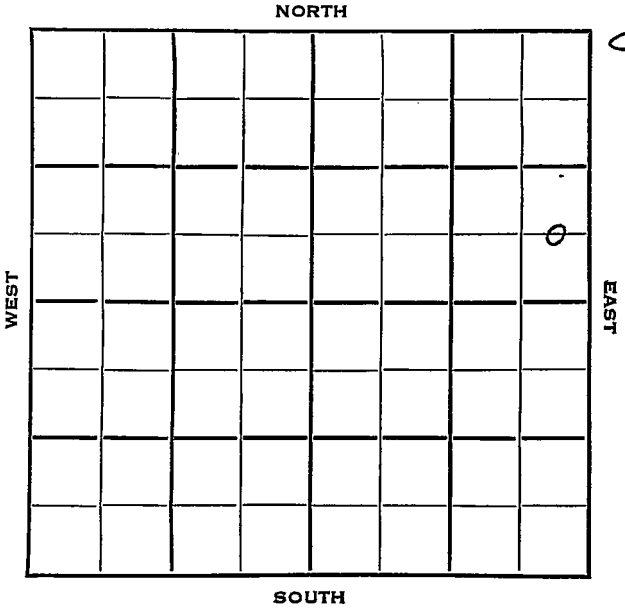

Sec. 35 Twp. 10 R. 21W

Well No. #2 Lewis Farm

Ted Gore & Stanolind Company

Contractor


_____ Ft. from N. Line

660 Ft. from S. Line

330 Ft. from E. Line

_____ Ft. from W. Line

C E L S E N E

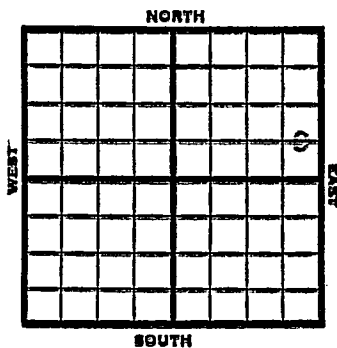

1953

Elev. 2141'

REPORT

9/2

Spud 8-26-53
8" @ 224'
Drlg. 2780'

9/9

Top 3162, Heeb 3368, Tor 3396, Lans 3413, B KC 3639, Penn Cong 3681, Arb. 3711
RTD 3724
5" @ 3718'

9/16

CO 3724' FU 2700' oil 5 hrs.
P/204 BO 13 hrs.

9/23

Spud 8-26-53
Oil Well
TD 3724'
8" @ 224'
Top 3162', Heeb 3368', Tor 3396',
Lans 3413', B KC 3639', Cong 3681',
Arb. 3711'
TD 3724'
5" @ 3718'
CO to 3724', FU 2700' oil, 5 hrs.
P/204 bo 13 hrs.
Comp. 525 bopd

COMPLETED

