

DX 78-1


Graham

KANSAS

Section 35 Township 10 Range 21W

Well No. #4 Schneider "B"

Company Kaiser & Francis O & G

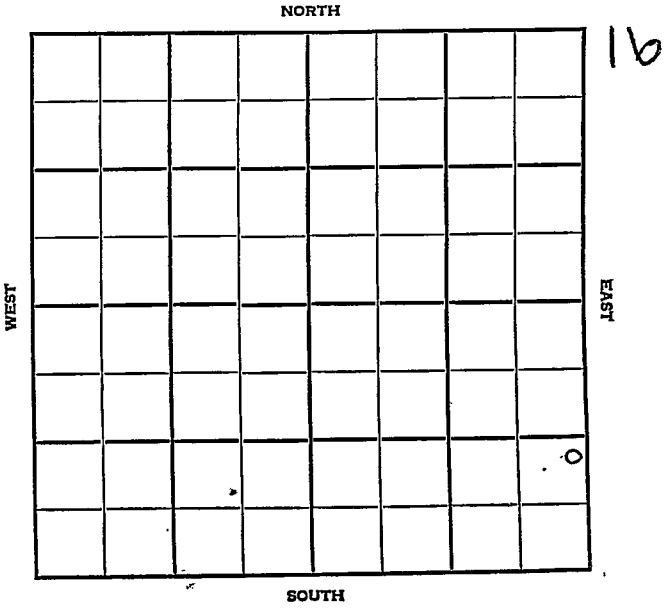

Graham

KANSAS

SEC.	TWP.	R.
35	10	21 W

WELL NO.

4 Schneider "B"

FARM

COMPANY

Kaiser & Franics O & G

CONTRACTOR

SW White Pool

Ft. from N. Line

1120


Ft. from S. Line

150

Ft. from E. Line

Ft. from W. Line

NE SE SE

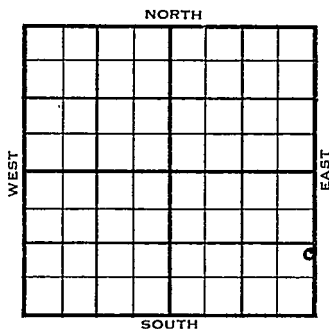

1954

ELEVATION

2094'

REPORT

10/27

Spud 10-21-54

8" @ 205

Drlg. 2670'

11/23

Spud 10-21-54 D & A TD 3698

8" @ 205 Heeb 3328 Lans 3369

B KC 3603 Cong. 3642 Ch. Cong 3654

Arb. 3671 TD 3675 5" @ 3672

DD 3698 oil & wtr. PB 3688 250 A

sd-oil-frac S/1/2 BO 1 1/2 BW D & A

ABANDONED

County Graham State Kansas

Sec. **35** (Blk.) **10** (Sur.) **21W** Map No.

Operator Kaiser & Francis O & G

Well No. 4 Farm Schneider "B"

Elev. **2094** Location **NE SE SE**

FIRST REPORT

1126 ft. From S Line SE

150ft. From E Line Quarter

1st. Report OCT 27 1954

Completion

Remarks


Spudding Date **10-21-54**

Drig. Data SW White Pool

8th @ 205 drlg. 2670

FABER CASTROL STRAP

County Graham State Kansas
 Sec. 35 (Blk. 10 (Sur. 21W Map No.
 (Twp.) (Rge.)
 Operator Kaiser & Francis Oil & Gas
 Well No. 4 Farm Schneider "B"
 Elev. 2094 Location NE SE SE

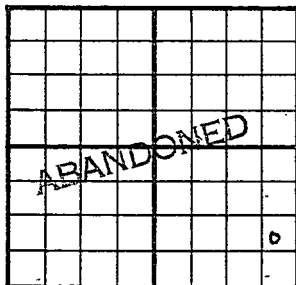

1120 Ft. From S Line SE
150 Ft. From E Line Quarter

1st. Report

Completion NOV 23 1954

Remarks SW White Pool

Spudding Date 10-21-54

Drlg. Data D & A TD 3698

8" @ 205 Heeb. 3328 Lans. 3369

Arb. 3668 B KC 3603 Cong. 3642

Ch. Cong. 3654 Arb. 3671 TD 3675

5" @ 3672 DD 3698 oil & wtr. PB 3688

250 A sd-oil-frac S/ $\frac{1}{2}$ bo $1\frac{1}{2}$ bw

D & A

FABEN GILST