

Section 35 Township 10 Range 21WWell No. #1 ZieglerCompany Harry Gore

C								
.								

NORTH

WEST

EAST

SOUTH

5

Sec. 35 Twp. 10 R. 21 W

Well No. # 1 Ziegler Farm

Harry Gore Company

Empire Contractor

Wildcat


 Ft. from N. Line

990 Ft. from S. Line

 Ft. from E. Line

330 Ft. from W. Line

NW SW NW

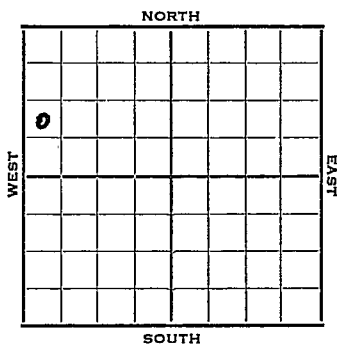

1952

Elev. 2119'

REPORT

6/18

Cellar & Pits

6/25

8" @ 193 Anhy 1580'

Drlg. 2770'

7/2

Spud 6-18-52

D&A TD 3807'

8" @ 193'

Anhy 1580

Top. 3171

Heeb. 3381

Tor. 3404

Lans. 3420

B KC 3642

Cong. 3723

Arb. 3755

TD 3807 D&A

ABANDONED

County Graham State Kansas
 Sec. 35 (Blk.) 10 (Sur.) 21W Map No.
 Operator Harry Gore
 Well No. 1 Farm Ziegler
 Elev. 2119 Location NW SW NW

FIRST REPORT

990 Ft. From S Line NW

830 Ft. From U Line Quarter

Ist. Report JUN 18 1952

Completion

Remarks


Empire - Contr.

Spudding Date

Drlg. Data Wildcat

Collar & pits

J. G. McGEHEE

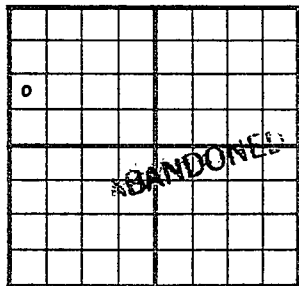County Graham State KansasSec. 35 (Blk.
Twp.) 10 (Sur.
Rge.) 21W Map No.Operator Harry GoreWell No. 1 Farm ZieglerElev. 2119 Location NW SW NW990 Ft. From S Line NW330 Ft. From W Line Quarter

1st. Report

Completion JUL 2 1952Remarks WildcatEmpire Drlg. - Contr.Spudding Date 6-18-52Drlg. Data D & A TD 38078" @ 193 Anhy 1580 Top. 3171Heeb. 3381 Tor. 3404 Lens. 3420B KC 3642 Cong. 3723 Arb. 3755 TD 3807D & A