


Section 35 Township 10 Range 21 W

Well No. # 3 Zeigler

Company Gore & Veeder

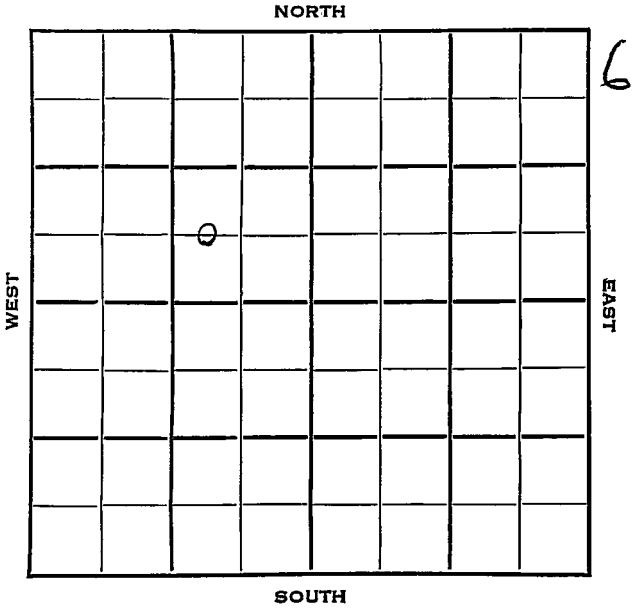

Graham

KANSAS

SEC.	TWP.	R.
35	10	21 W

WELL NO.

3 Zeigler

FARM

COMPANY

Gore & Veeder

CONTRACTOR

Veeder

SW White Pool

Ft. from N. Line

660


Ft. from S. Line

990

Ft. from E. Line

Ft. from W. Line

C W L SE NW

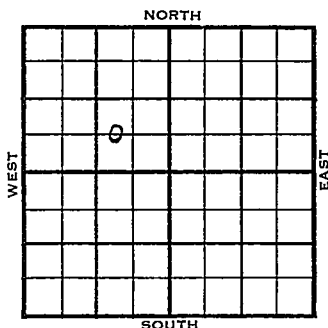

ELEVATION

1954

2100'

REPORT

3/24

Spud 3-20-54

8" @ 213 Anhy 1565

Drlg. 2065'

3/31

Heeb 3333 Lans 3373 Arb. 3680

RTD 3682 5" @ 3681

4/7

CO 3682' FU 2300' oil 2 hrs.

P/190 BO 9 hrs.

4/14

"

4/21

Spud 3-20-54

Oil Well

TD 3682'

8" @ 213'

Anhy 1565', Heeb 3333', Lans 3373',

Arb. 3680'

TD 3682'

5" @ 3681'

CO to 3682'

FU 2300' oil 2 hrs.

P /190 bo 9 hrs.

Comp. 446 bopd

COMPLETED

County Graham State Kansas

Sec. 35 (Blk. 10 (Sur. 21W (Twp.) 10 (Rge.) 21W Map No.

Operator Gore & Veeder

Well No. 3 Farm Zeigler

Elev. 2100 Location C W L SE NW

660 Ft. From S Line NW

990 Ft. From E Line Quarter

1st. Report

Completion APR 21 1954

Remarks SW White Pool

Veeder - Contr.

Spudding Date 3-20-54

Drilg. Data Oil well TD 3682

8" @ 213 Anhy 1565 Heeb. 3333

Lans. 3373 Arb. 3680 TD 3682

5" @ 3681 CO to 3682 FU 2300' oil 2 hr.

P/ 190 bo 9 hr. Comp. 446 bopd