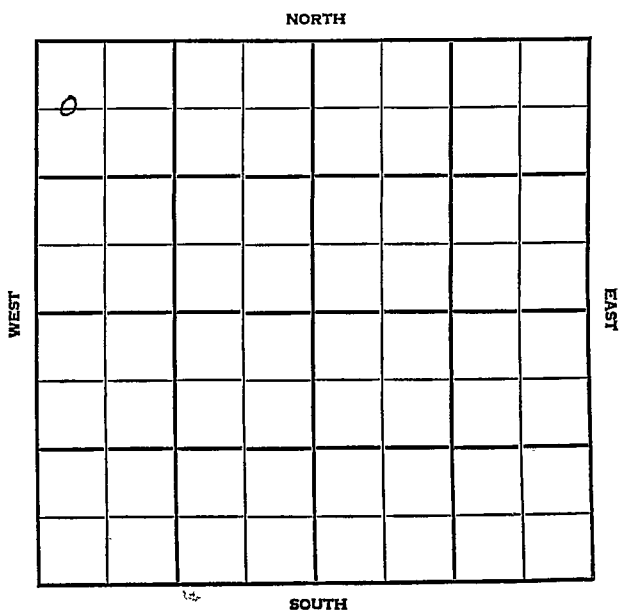


Section 35 Township 10 Range 22 WWell No. #1 Neah "D"Company Petroleum Inc.

Graham

KANSAS

SEC.	TWP.	R.
35	10	22W

WELL NO.

#1 Noah "D"

FARM

COMPANY

Petroleum Inc.

CONTRACTOR


Faulkner

_____ Ft. from N. Line

_____ Ft. from S. Line

_____ Ft. from E. Line

_____ Ft. from W. Line

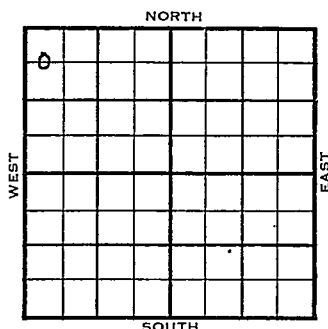C W $\frac{1}{2}$ NW NW

1955

ELEVATION

2268'

REPORT

7/22

Comm 6-24-55

8 5/8" @216/150 DST 3517-55 open 1 hr.

Rec. 30' socm DST 3581-3631 open 1 hr.

Rec. 550' hocm 750/20" DST 3608-31 open

1 hr. Rec. 200' sw 150' hocm 100' frog-

gy oil 750/20" DST 3580-3602 open 1 hr.

Rec 140' ho & gcm 280/20" DST 3684-3710

open 45 min. Rec. 6' mud 0/20" DST

3847-60 open 1 hr. Rec. 65' vhocm

1100/20" 5 1/2" @3865 CO to 3888 32/3844-

60 500A S/1 boph 5% bsw S/5 1/2 boph Comp.

100 bopd 20% wtr.

Anh. 1764-~~2014~~

Tp. 3282-1014

H. 3493-1225

L. 3532-1264

C. 3907-1639

A.Raw 3913-1645

Aro. 3920-1652

TD 3938

FIRST REPORT

COMPLETED

County Graham Elev. 2268
 Sec. 35 Twp. 10 Rge. 22W
 Company Petroleum Inc.
 Farm Name Noah "D" No. 1

TOPS	DEPTH	LOG	DATUM	Loc. in Sec.
Anh.	<u>1764</u>			<u>C W¹/₂ NW NW</u>
T.P.	<u>3282</u>		<u>1014</u>	
H.	<u>3493</u>		<u>1225</u>	
Tr.				
Dg.				
BL.				
L.	<u>3532</u>		<u>1264</u>	Geol.
K.C.				Contr.
B.K.C.				
Ce.				
C.	<u>3907</u>		<u>1639</u>	Pool
M.				<u>Faulkner</u>
M.				
K.				
Mz.				
Mq.				
V.				
S.				
S.				
A. <u>R.W.</u>	<u>3913</u>		<u>1645</u>	FIRST REPORT COMPLETE
<u>R.V.B.</u>	<u>3920</u>		<u>1652</u>	
PE.				
G.				
T.D.	<u>3930</u>			

Date Comm. 6-24-55 JUL 20 1955
8 5/8" @ 216/150 DST 3517-55 open 1 hr.
Rec. 30' socm DST 3581-3631 open 1 hr.
Rec. 550' hocm 750/20" DST 3608-31
open 1 hr. Rec. 200' sw 150' hocm
100' froggy oil 750/20" DST 3580-3602
open 1 hr. Rec. 140' ho & gcm 280/20"
DST 3684-3710 open 45 min. Rec. 6' mud
0/20" DST 3847-60 open 1 hr. Rec.

OVER 5

65' vhoem 1100/20" 5 $\frac{1}{2}$ " @ 3865

CO to 3888 32/ 3844-60 500 A.

S/ 1 boph 4% bsw S/ 5 $\frac{1}{2}$ boph

Comp. 100 bopd 20% wtr.