

Sec. 36 Twp. 10 R. 16W

Well No. #1 Fledkamp Farm

Pickrell Drlg. Company

Pickrell Drlg. Contractor

Krueger Pool


Ft. from N. Line

330' Ft. from S. Line

Ft. from E. Line

450' Ft. from W. Line

SW SE

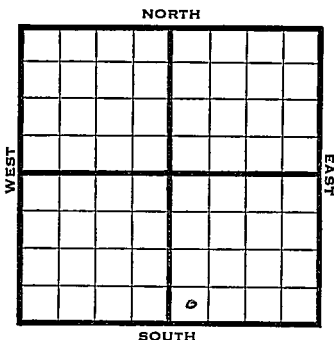

1949

Elev 2039' REPORT

11/2

8" @ 291'

Drlg. 2360'

11/9

TD 2604' in Cong.

Lans 3234'

Cong 3568'

Aband.

ABANDONED

Map No. _____ Sec. 36 Twp. 10 R. 16W

Well No. 1 Fledkamp

Pickrell Drlg. _____ Company

Pickrell Drlg. _____ Contractor

SW SE

FIRST REPORT
SECTION PLAT

_____ Ft. from N. Line

330 _____ Ft. from S. Line

_____ Ft. from E. Line

450 _____ Ft. from W. Line

Rooks County

Location _____

Rig up _____

Drilling and Remarks:

8" @ 291
drilg. 2360

RECORD .

Cased _____ in, _____ ft.

Sand _____

Gas _____

Oil _____

Total Depth _____

PRODUCTION

1st 24 hrs. Nat. _____

1st 24 hrs. after shot _____

Gas _____ Cu. Ft.

Dry Hole _____

Abandoned _____

Date

NOV 2 1949 19

S. J. LEWIS Scout

Kansas

Map No. _____ Sec. 36 Twp. 10 R. 16W

Well No. 1 Fledkamp


Pickrell Drlg.

Company

ABANDONED

Contractor

SW SE

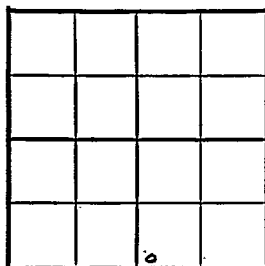E 1,2039
SECTION PLAT

_____ Ft. from N. Line

330 _____ Ft. from S. Line

_____ Ft. from E. Line

450 _____ Ft. from W. Line

Rooks County

Location _____

Rig up _____

Drilling and Remarks:

Ham 3234

Cmg 3568

RECORD

Cased _____ in., _____ ft.

Sand _____

Gas _____

Oil _____

Total Depth 3204 in Cmg

PRODUCTION

1st 24 hrs. Nat. _____

1st 24 hrs. after shot _____

Gas _____ Cu. Ft.

Dry Hole _____

Abandoned _____

Date

NOV 9 1949 19

S. J. LEWIS

Scout