


Section 36 Township 10 Range 18 W

Well No. # 3 Kempe

Company Peel-Hardman

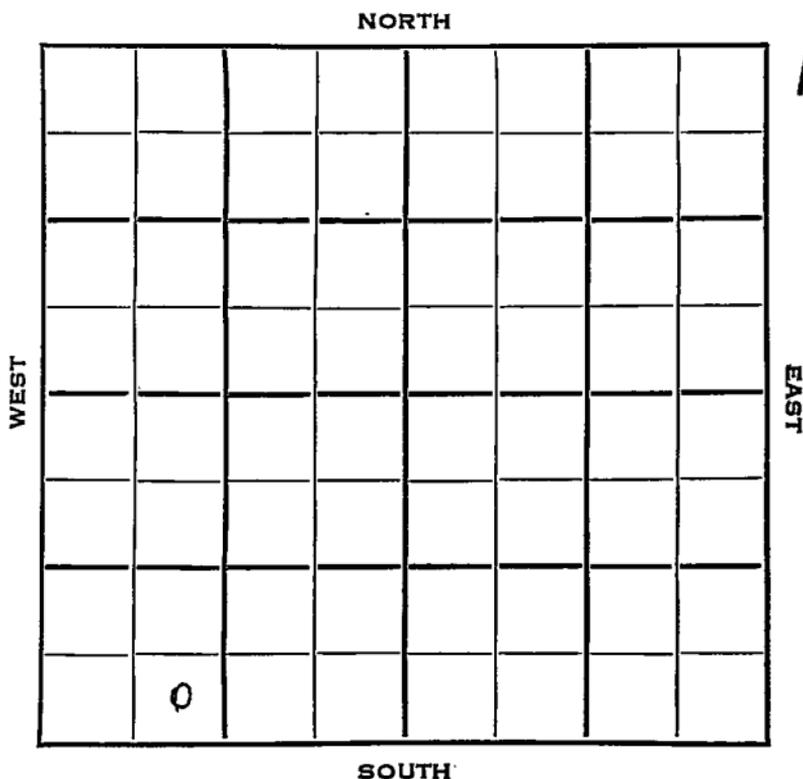

Rooks KANSAS


SEC.	TWP.	R.
36	10	18W ✓

WELL NO. 3 Kempe FARM

COMPANY Peel-Hardman

CONTRACTOR Peel
Burnett Pool

_____ Ft. from N. Line
330 Ft. from S. Line
_____ Ft. from E. Line
990 Ft. from W. Line

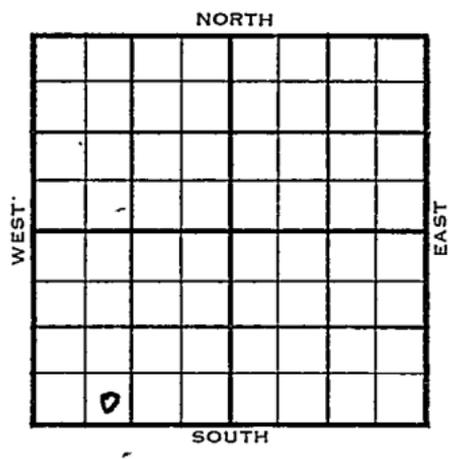

SE SW SW

	ELEVATION	REPORT
1953	2073'	
12/30	spud 12-26-53 8" @ 187' Drlg. 1300'	
1954 1/6	Anhy 1375' Lans 3332' DST 3355-76, 1/2 hr, 10' M 500# DST 3469-96, 1/2 hr, 18' M 310#	
1/13	Cong. 3560' Simp. 3615' Arb. 3636' RTD 3642' 5" @ 3637'	
3/3	Spud 12-26-53 Oil Well TD 3642' 8" @ 187' Anhy 1375', Lans 3332' DST 3355-76', opn 1/2 hrs., rec. 10' mud, 500# DST 3469-96', opn 1/2 hrs., rec. 18' mud, 310# Cong 3560', Simp 3615', Arb. 3636' TD 3642' 5" @ 3637', CO to 3642', 500A, 1000A S/7 1/2 bf 1 hr., 50% wtr, S/6-3/4 bf 4th hr., 50% wtr. Comp. 35 bopd 65% wtr.	

COMPLETED

