

Rooks


FORM 51 IOM 12-46 PETROL

KANSAS

Section 36 Township 10 Range 18W

Well No. 2 Riddler "B"

Company Republic Natural Gas

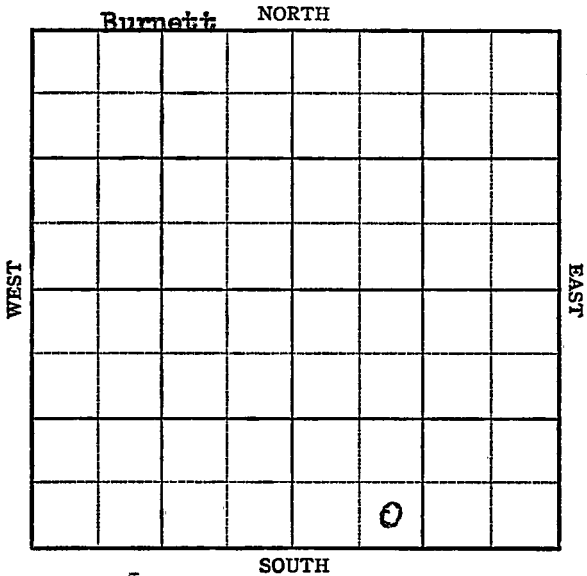

KANSAS

Rooks

Sec. 36 Twp. 10 R. 18WWell No. #2 Riddler "B" Farm
Republic Natural Gas Company

Burnett

Ft. from N. Line

330


Ft. from S. Line

Ft. from E. Line

990

Ft. from W. Line

SE SW SE

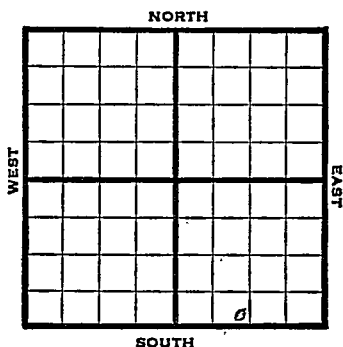

1947	Elev. 2058' REPORT
9/10	RUR
9/17	10" @ 1347' WOC
9/24	Drilg. 2490'
10/1	Lansing 3276' Drilg. 3330'
10/8	Conglomerate 3518' Simpson 3569' Arbuckle 3599' TD 3604' 7" @ 3600' RUST
10/15	500 acid Swab 170 bbls. oil in $3\frac{1}{2}$ hrs.
10/22	"
10/29	"
11/5	"
11/12	"
11/19	Arb. 3599' 7" @ 3600' 500 acid. Depth Pot 2018 $\neq$ 4% W Gr. 36.0 TD 3604'

COMPLETED

Map No. _____ Sec. 36 Twp. 10 R. 18W

Well No. 2 Riddler "B"

Republic Natural Gas Company

FIRST REPORT Contractor

SE SW SE


SECTION PLAT

_____ Ft. from N. Line

330 _____ Ft. from S. Line

_____ Ft. from E. Line

990 _____ Ft. from W. Line

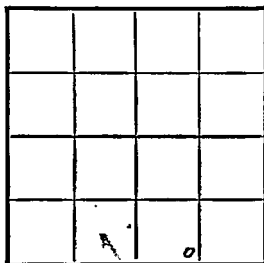

Rooks County

Location _____

Rig up _____

Drilling and Remarks:

E U R

RECORD

Cased _____ in. _____ ft.

Sand _____

Gas _____

Oil _____

Total Depth _____

PRODUCTION

1st 24 hrs. Nat. _____

1st 24 hrs. after shot _____

Gas _____ Cu. Ft.

Dry Hole _____

Abandoned _____

Date

SEP 10 1947 19 S. J. LEWIS Scout

Form 26 200 Bks. 10-46 Petrol
Kansas

Burnett Pool

Map No. 64 Sec. 36 Twp. 10 R. 18W

Well No. 2 Riddler "B"

Republic Natural Gas Company

COMPLETE

Contractor

SE SW SE

E1.2058


SECTION PLAT

 Ft. from N. Line

330 Ft. from S. Line

 Ft. from E. Line

990 Ft. from W. Line

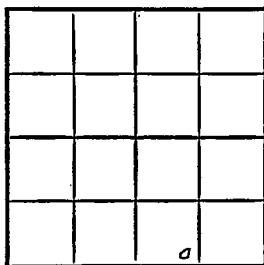

Rooks County

Location

Rig up

Drilling and Remarks:

Cr 83598
7" @ 3600
500 acid
Dep't to 20184
4 7/8 W.
36 2/3

RECORD

Cased in., ft.

Sand

Gas

Oil

Total Depth 3604

PRODUCTION

1st 24 hrs. Nat.

1st 24 hrs. after shot

Gas Cu. Ft.

Dry Hole

Abandoned

Date

NOV 19 1947

S. J. LEWIS Scout