

Section 36 Township 10 Range 18 W

Well No. #3 Ridler "B"

Company Republic Natural Gas

NORTH

						0	

16

WEST

EAST

SOUTH

Rooks

KANSAS

Sec. 36 Twp. 10 R. 18W

Well No. #3 Ridler "B" Farm

Republic Natural Gas Company

Gabbert & Jones - Contr. Contractor

Burnett Pool


 Ft. from N. Line

330' Ft. from S. Line

990' Ft. from E. Line

 Ft. from W. Line

SW SE SE

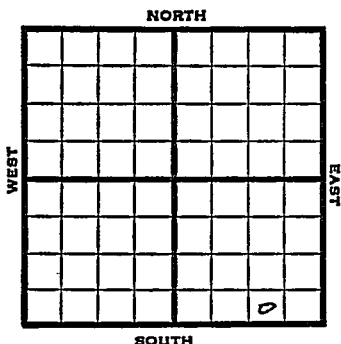

1951 Elev. 1930' REPORT

1/31 Spud 1-21-51
8" @ 248'
Anhy 1225'
Lans. 3159'
Drlg. 3190'

3/14 Spud 1-21-51
Oil Well TD 3487
8" @ 248'
Anhy 1225' Lans. 3159
Cong. 3402 Simp 3450
Arb. 3484
TD 3486 5" @ 3485
FU 150' oil 2 hr
S/ 3/4 boph DD 3487 250 A S/7 boph
Comp. 51 bopd 41% wtr

COMPLETED

J. E. TYRA

J. E. TYRA