

KANSAS


Rooks

FORM 51 25M 3-49 PETROL

Section 36 Township 10 Range 19-W

Well No. #1 Gasaway

Company V D Sidey
Zurick

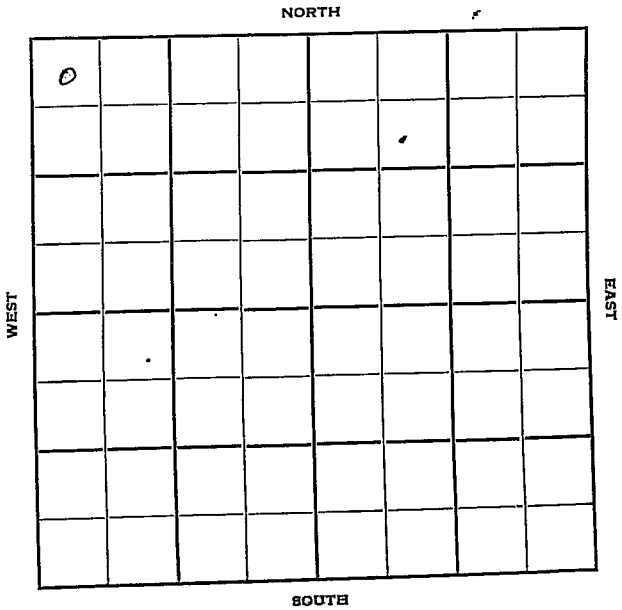

Rooks

KANSAS

Sec. 36 Twp. 10 R. 19W

Well No. #1 Gasaway Farm

V.D. Sidey

Company

Zurick Pool

(Murfin, Contr.)

NORTH

330'

Ft. from N. Line


Ft. from S. Line

Ft. from E. Line

330'

Ft. from W. Line

NW/C

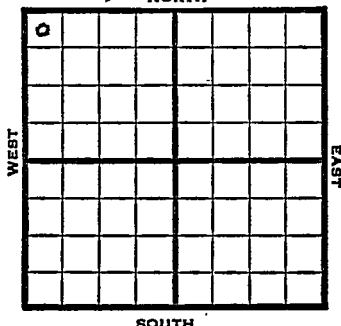

1949

Elev 2102'

REPORT

11/30

8" @ 100'

SO 3076-89

Drlg. 3112'

12/7

"

12/14

5" @ 3602'

12/21

"

12/28

"

1950

3/28

TD 3606'

8"@ 100'

5"@ 3602'

P/10 BOPD in KC

Comp

COMPLETED

Map No. _____ Sec. 36 Twp. 10 R. 19W

Well No. 1 Gasaway

V. D. Sidey Company

Murfin Drlg. Contractor


NW/C

FIRST REPORT
SECTION PLAT

330 Ft. from N. Line

_____ Ft. from S. Line

_____ Ft. from E. Line

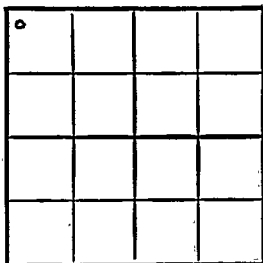330
_____ Ft. from W. Line

Rooks County

Location _____

Rig up _____

Drilling and Remarks:

8" @.100

SO 3076-89

drlg. 3112

RECORD

Cased _____ in., _____ ft.

Sand _____

Gas _____

Oil _____

Total Depth _____

PRODUCTION

1st 24 hrs. Nat. _____

1st 24 hrs. after shot _____

Gas _____ Cu. Ft.

Dry Hole _____

Abandoned _____

Date

NOV 30 1949 19

S. J. LEWIS

Scout

Kansas

Map No. _____ Sec. 36 Twp. 10 R. 19WWell No. 1 Gasaway

V. D. Sidey _____ Company


Contractor

NW/C

E. 2102
SECTION PLAT330 Ft. from N. Line

_____ Ft. from S. Line

_____ Ft. from E. Line

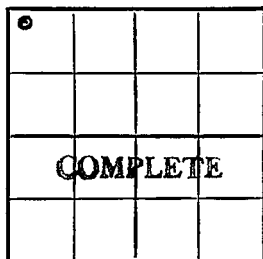330 Ft. from W. Line

Rooks County

Location _____

Rig up _____

Drilling and Remarks:

8" @ 100
5" @ 3602P 10 BOPD
in KC
d

RECORD

Cased _____ in., _____ ft.

Sand _____

Gas _____

Oil _____

Total Depth 3606

PRODUCTION

1st 24 hrs. Nat. _____

1st 24 hrs. after shot _____

Gas _____ Cu. Ft.

Dry Hole _____

Abandoned _____

Date

MAR 29 1950

J. E. TYRA

19

Scout