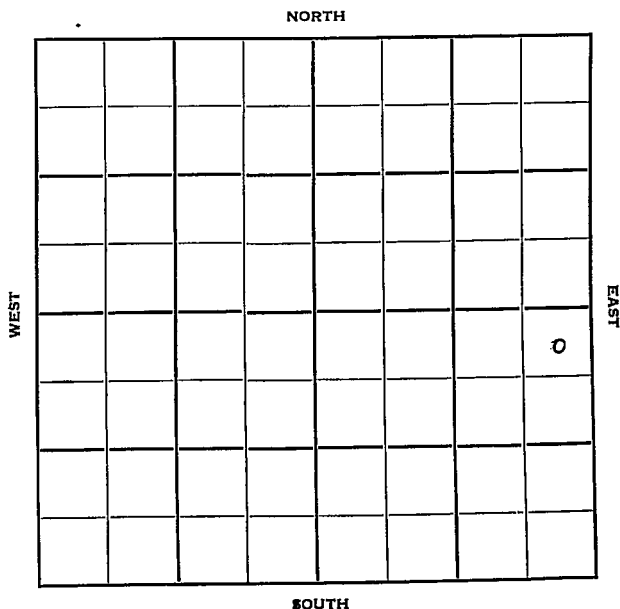


KANSAS

Section 36 Township 10 Range 20-WWell No. #1 KellerCompany Appleman etal
Wildcat

Rooks

KANSAS

36

10

20W

Sec. _____ Twp. _____ R. _____

Well No. #1 Keller Farm _____

Appleman Et al Company _____

Contractor _____

Wildcat


330' Ft. from N. Line

_____ Ft. from S. Line

330' Ft. from E. Line

_____ Ft. from W. Line

NE NE SE

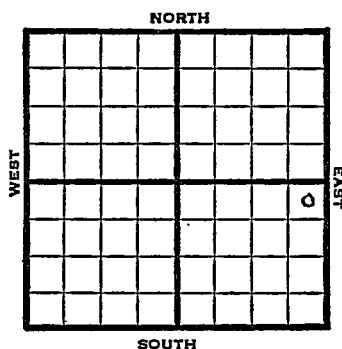

1950 Elev. 2158' REPORT

3/8 Location
3/22 8" @ 165'
Anhy 1570'
Heebner 3398'
Lans 3438'
SSO 3630-36
BKG 3646'
Cong 3711'
TD 3861'
D&A
Aband.
ABANDONED

Map No. _____ Sec. 36 Twp. 10 R. 20WWell No. 1 Keller_____Appleman et al._____
Company_____
Contractor
NE NE SE El. 2158

SECTION PLAT

330 Ft. from N. Line_____
Ft. from S. Line330 Ft. from E. Line_____
Ft. from W. LineRooks CountyGulf & Sinclair DHM

Location _____

Rig up _____

Drilling and Remarks:

RECORD

Cased _____ in., _____ ft.

Sand _____

Gas _____

Oil _____

Total Depth _____

PRODUCTION

1st 24 hrs. Nat. _____

1st 24 hrs. after shot _____

Gas _____ Cu. Ft.

Dry Hole _____

Abandoned _____

Date

MAR 8 1950 19J. E. TYRAScout

Kansas

Wildcat

Map No. _____ Sec. 36 Twp. 10 R. 20WWell No. 1 Keller

_____ Appleman etal. _____ Company

_____ Contractor

NE NE SE


SECTION PLAT

330 Ft. from N. Line

_____ Ft. from S. Line

330 Ft. from E. Line

_____ Ft. from W. Line

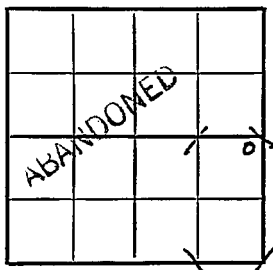

Rooks County

Location _____

Rig up _____

Drilling and Remarks:

8" @ 165
 anhy 1570
 Heeliner 3398
 Lams. 3438
 SSD 3630-36
 RKC 3646
 Cong. 3711
 T.D. 3861

RECORD

Cased _____ in., _____ ft.

Sand _____

Gas _____

Oil _____

Total Depth _____

PRODUCTION

1st 24 hrs. Nat. _____

1st 24 hrs. after shot _____

Gas _____ Cu. Ft.

Dry Hole _____

Abandoned _____

D + A

Date

MAR 22 1950 19

J. E. TYRA Scout