


Section 36 Township 10 Range 21W

Well No. #2 C.V. Lewis

Company Harry Gore

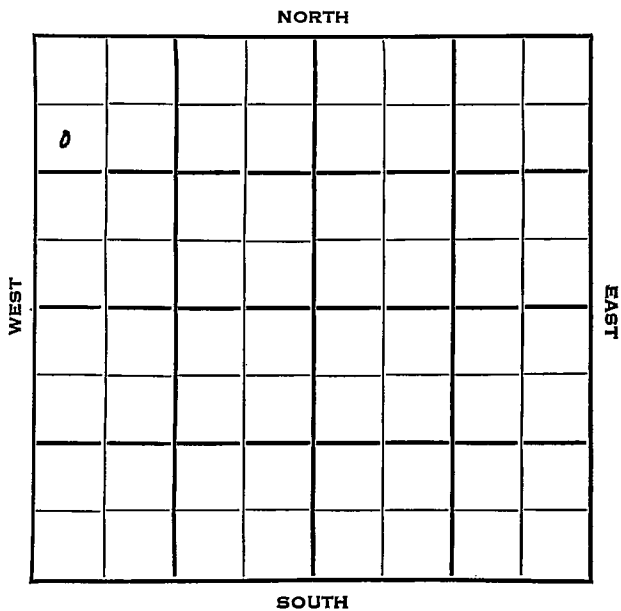

SEC.	TWP.	R.
36	10	21W ✓

WELL NO. #2 C.V. Lewis FARM

COMPANY Harry Gore

CONTRACTOR Veeder

SW White Pool

990	Ft. from N. Line	<table border="1"> <tr><td></td><td></td><td></td><td></td><td></td><td></td><td></td><td></td></tr> <tr><td>0</td><td></td><td></td><td></td><td></td><td></td><td></td><td></td></tr> <tr><td></td><td></td><td></td><td></td><td></td><td></td><td></td><td></td></tr> <tr><td></td><td></td><td></td><td></td><td></td><td></td><td></td><td></td></tr> <tr><td></td><td></td><td></td><td></td><td></td><td></td><td></td><td></td></tr> <tr><td></td><td></td><td></td><td></td><td></td><td></td><td></td><td></td></tr> </table>									0																																							
0	
	Ft. from S. Line	
	Ft. from E. Line	
330	Ft. from W. Line	
SW NW NW	

1954	ELEVATION	REPORT
	2161'	

3/31	Spud 3-30-54 8" @ 222'
4/7	WOC. Anhy 1620 Top 3185 Heeb 3392 Tor. 3416 KC 3433 Drlg. 3645'
4/14	"
4/21	Spud 3-30-54 Oil Well TD 3740 8" @ 222' Anhy 1620', Top 3185', Heeb 3392', Tor 3416', KC 3433', Arb. 3729' TD 3732' 5" @ 3730' DD 3740 P/18 boph omp. 373 bopd

COMPLETED

County Graham State Kansas

Sec. 36 (Blk. Twp.) 10 (Sur. Rge.) 21W Map No.

Operator Harry Gore

Well No. 2 Farm C. V. Lewis

Elev. 2161 Location SW NW NW

0					

990 Ft. From N Line NW

330 Ft. From W Line Quarter

1st. Report MAR 31 1954

Completion _____

Remarks _____

Veeder - Contr.

Spudding Date 3-30-54

Drlg. Data SW White Pool

8" @ 222 WOC

County Graham State Kansas

Sec. 36 (Blk. 10) (Sur. 2) (Rge. 1W) Map No.

Operator Harry Gore

Well No. 2 Farm C. V. Lewis

Elev. 2161 Location SW NWNW

o					
COMPLETE					

990 Ft. From N Line NW

330 Ft. From W Line Quarter

1st. Report

Completion APR 21 1954

Remarks SW White Pool

Weeder - Contr.

Spudding Date 3-30-54

Drlg. Data Oil well TD 3740

8" @ 222 Anhy 1620 Top. 3185

Heeb. 3392 Tor. 3416 KC 3433

Arb. 3729 TD 3732 5" @ 3730

DD 3740 P/ 18 boph Comp. 373 bopd