


Section 36 Township 10 Range 21 W

Well No. # 3 C. V. Lewis

Company Harry Gore

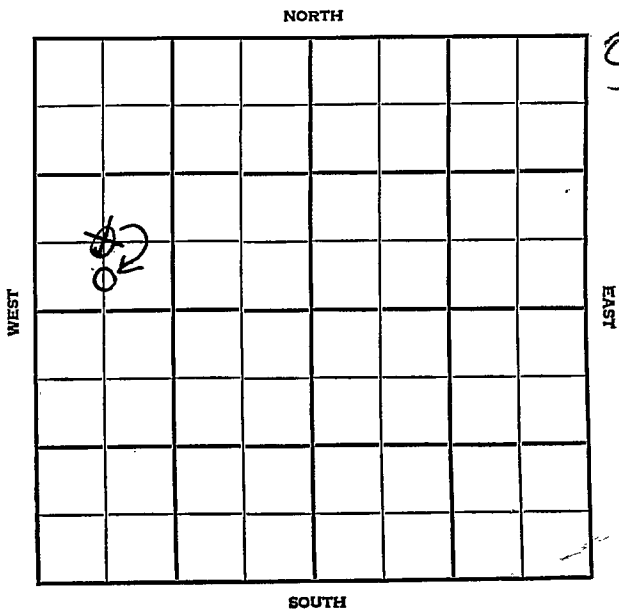

Graham KANSAS

SEC.	TWP.	R.
36	10	21W 21W

WELL NO. 3 C. V. Lewis FARM

COMPANY Harry Gore

CONTRACTOR Veeders


S. W. White Pool

_____ Ft. from N. Line

660 330 _____ Ft. from S. Line

_____ Ft. from E. Line

660 _____ Ft. from W. Line

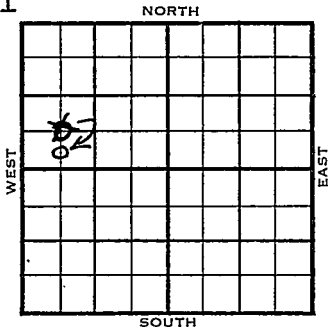

c.s/2
SW NW

1954	ELEVATION 2123'	REPORT
------	-----------------	--------

~~7/14~~
~~XXXX~~

MIR

7/21 8" @ 186 w/125
Drlg. 3315'

7/28 Spud 7-13-54 D & A TD 3825'
8" @ 186 Any 1580' Top 3152'
Heeb 3360' Tor. 3384 KC 3400
B KC 3628 Cong. 3666 Arb. 3789
TD 3825 D & A

ABANDONED.

Map No. _____ Sec. 36 Twp. 10 R. 21W

Well No. 3 C. V. Lewis

Harry Gore Company

CORRECTION Contractor

C S $\frac{1}{2}$ SW NW

SECTION PLAT

_____ Ft. from N. Line

330 Ft. from S. Line

_____ Ft. from E. Line

660 Ft. from W. Line

6			

Graham County

Location _____

Rig up _____

Drilling and Remarks:

Reported
C SW NW

RECORD

Cased _____ in., _____ ft.

Sand _____

Gas _____

Oil _____

Total Depth _____

PRODUCTION

1st 24 hrs. Nat. _____

1st 24 hrs. after shot _____

Gas _____ Cu. Ft.

Dry Hole _____

Abandoned _____

Date

JUL 21 1954

J. G. MCGHEE Scout

