


SECTION 36 TOWNSHIP 10 RANGE 21 W

WELL NO. #8 Fondoble

COMPANY Cities Service

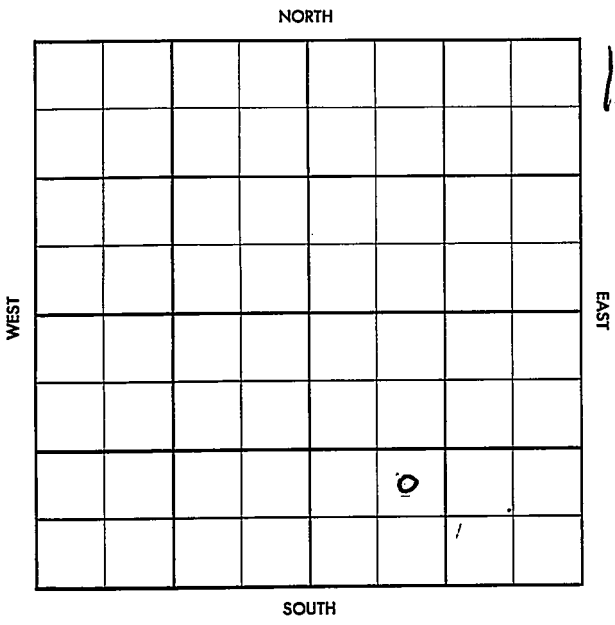

SEC.	TWP.	R.
36	10	21W

WELL NO.

#8 Fondoble

FARM

COMPANY

Cities Service

CONTRACTOR

L &amp; J

SW White


\_\_\_\_\_ Ft. from N. Line

\_\_\_\_\_ Ft. from S. Line

\_\_\_\_\_ Ft. from E. Line

\_\_\_\_\_ Ft. from W. Line

NE SW SE

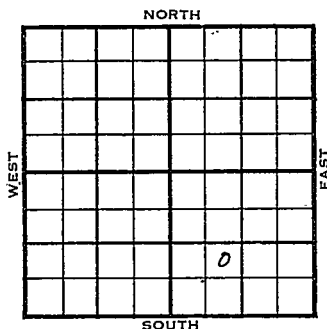

	ELEVATION	REPORT
1956	2139	
1-5	Comm. 1-1-56 8" @ 240/175 Drlg. 2745	
1-25	DST 3559-90 op $\frac{1}{2}$ hr. rec. 80' m&w, 940/20" DST 3591-3633 op $\frac{1}{2}$ hr. rec. 20' mud, 480/20" 5 $\frac{1}{2}$ " @ 3726 DD 3735 DD 3743, 500 A P/ 45 bo 5 hra. Comp. 174 bopd Tp. 3169 H. 3377 Dodge 3401 L. 3415 BKC 3643 Cherty 3662 E rros 3707 A. 3725 TD 3728'	
<b>COMPLETED</b>		

County Graham Elev. \_\_\_\_\_  
 Sec. 36 Twp. (10) Rge. 21W  
 Company Cities Service  
 Farm Name Fondoble No. 8

TORS	DEPTH	LOG	DATUM
Anh.			
Tp.			
H.			
Tr.			
Dg.			
Bl.			
L.			
K.C.			
B.K.C.			
Ce.			
C.			
M.			
M.			
K.			
Mz.			
Ma.			
V.			
S.			
S.			
A.			
R.			
Pe.			
G.			
T.D.			

Loc. in Sec. NE SW SE

Geol. \_\_\_\_\_

Contr. L & J

Pool SW White

JAN 5 1956
FIRST REPORT

Date Comm. 1-1-56

8" @ 240/175 drlg. 2745

*[Handwritten signature]*

Co.

Lse.

No.

Sec.

T.

R.

County Graham Elev. 2139  
 Sec. 36 Twp. 10 Rge. 21W  
 Company Cities Service  
 Farm Name Fondoble No. 8

TOPS	DEPTH	LOG	DATUM	Loc. in Sec.
Anb.				NE SW SE
TP.	<u>3169</u>			
H.	<u>3377</u>			
Tr.				
Dg. <u>Dodge</u>	<u>3401</u>			
Bl.				
L.	<u>3415</u>		<u>1276</u>	Geol.
K.C.				Contr.
B.K.C.	<u>3643</u>		<u>1504</u>	<u>I &amp; J</u>
Ce.				Pool
C. <u>Cherry</u>	<u>3662</u>		<u>1523</u>	<u>SW White</u>
M.				
M.				
K.				
Mz.				
Mg.				
V.				
S.				
S. <u>erras</u>	<u>3707</u>		<u>1568</u>	COMPLETE
A.	<u>3725</u>		<u>1586</u>	
R.				
PE.				
G.				
TR.	<u>3728</u>			

Date Comm. 1-1-56 JAN 25 1956  
 8" @ 240/175 DST 3559-90 open  $\frac{1}{2}$  hr.  
 rec. 80' m & w 940/20" DST 3591-3633  
 open  $\frac{1}{2}$  hr. rec. 20' mud 480/20"  
 5 $\frac{1}{2}$ " @ 3726 DD 3735 DD 3743 500 A  
 P/ 45 bo' 5 hr. Comp. 17 $\frac{1}{4}$  bopd