


Section 36 Township 10 Range 21W

Well No. #2 Schneider

Company H.G. Kaiser & M.B. Armer

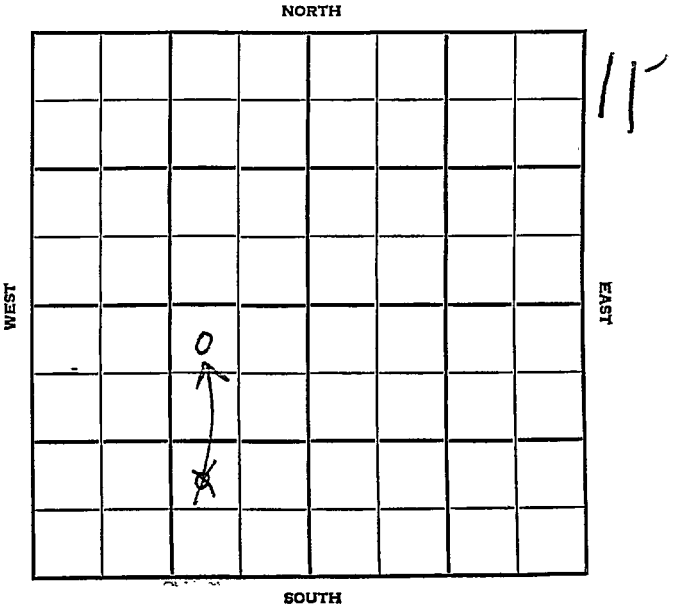

Graham KANSAS

SEC.	TWP.	R.
36	10	21W

WELL NO.

2 Schneider

FARM

COMPANY

H. G. Kaiser & M. B. Armer

CONTRACTOR

Co. Tools


SW White Pool

~~330~~ Ft. from N. Line

~~990~~ Ft. from S. Line

990 Ft. from E. Line

Ft. from W. Line

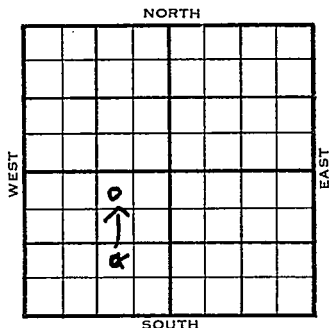

<sup>NE</sup>  
NW SE SW

1954	ELEVATION	REPORT
	2116	

4/27 MIR

5/5 D<sub>r</sub>lg. 2890'

5/12 Heeb 3349 Tor 3370 Lans 3387  
Arb. 3681  
DST 3683-91, 1 hr, 1130' oil 940#  
RTD 3691 5" @ 3685

5/19 CO 3691 FU 1500' oil 3 hrs.  
S/11 BOPH 6 hrs. POP

7/21 TD 3691  
Oil well  
Heeb 3349 Tor. 3370 Lans. 13387  
Arb. 3681  
DST 3683-91 open 1 hr. Rec. 1130'  
oil 940#  
TD 3691  
5" @ 3685  
CO to 3691 FU 1500' oil 3 hr.  
S / 11 boph 6 hr.  
Comp 268 bopd

COMPLETED



Kansas

Map No. \_\_\_\_\_ Sec. 36 Twp. 10 R. 21W

Well No. 2 Schneider

H. G. Kaiser & M. B. Armer Company

**CORRECTION**

Contractor

NW NE SW

**SECTION PLAT**

330 Ft. from N. Line

\_\_\_\_\_ Ft. from S. Line

990 Ft. from E. Line

\_\_\_\_\_ Ft. from W. Line

	o		

Graham County

Location \_\_\_\_\_

Rig up \_\_\_\_\_

Drilling and Remarks:

Reported

NW SE SW

**RECORD**

Cased \_\_\_\_\_ in., \_\_\_\_\_ ft.

Sand \_\_\_\_\_

Gas \_\_\_\_\_

Oil \_\_\_\_\_

Total Depth \_\_\_\_\_

**PRODUCTION**

1st 24 hrs. Nat. \_\_\_\_\_

1st 24 hrs. after shot \_\_\_\_\_

Gas \_\_\_\_\_ Cu. Ft.

Dry Hole \_\_\_\_\_

Abandoned \_\_\_\_\_

Date

MAY 5 1954 19

J. G. MCGHEE Scout

