


Section 36 Township 10 Range 21W

Well No. 4 Schneider "A"

Herman Kaiser + Francis O + S.
Company M. B. Armeretal

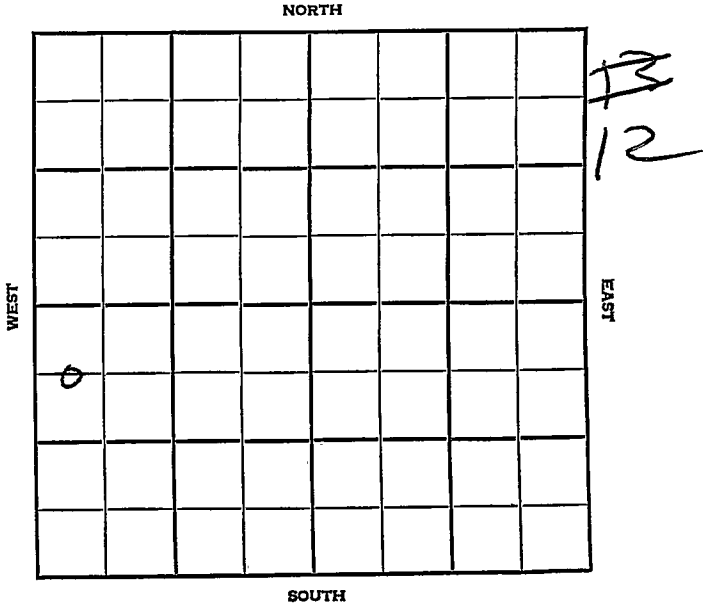

Graham

KANSAS

SEC.	TWP.	R.
36	10	21W

WELL NO. _____

#1 Schneider "A"

FARM

COMPANY **HERMAN KAISER & FRANCIS O & G**
~~M.B. Armeretal~~

CONTRACTOR **Armer Tools**

SW White Pool


NORTH

660 Ft. from N. Line

_____ Ft. from S. Line

_____ Ft. from E. Line

~~150~~
~~330~~ Ft. from W. Line

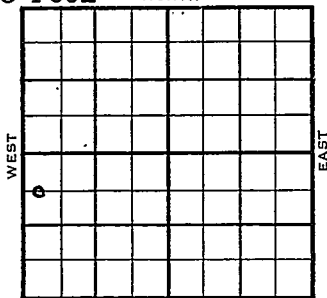

C W/2 NW SW

1954	ELEVATION 2098'	REPORT
------	--------------------	--------

9/29 Spud 9-27-54
8" @ 207'
WOC.

11/23 Spud 9-27-54
Oil Well
TD 3669'
8" @ 207'
Heeb 3329', Tor 3350', Lans 3369'
Cong 3640' Arb. 3663'
TD 3666'
5" @ 3664'
DD 3669' S/ 22 boph 6 hr.
Comp 400 bopd.

COMPLETED

Kansas

Map No. _____ Sec. 36 Twp. 10 R. 21W

Well No. 4 Schneider "A"

Herman Kaiser & Francis O & G Company

Contractor

C W $\frac{1}{2}$ NW SW

SECTION PLAT

660 Ft. from N. Line

_____ Ft. from S. Line

_____ Ft. from E. Line

150 Ft. from W. Line

o			

Graham County

Location _____

Rig up _____

Drilling and Remarks:

Reported

M.B. Armer et al.

Correct ft meas (3)

RECORD

Cased _____ in., _____ ft.

Sand _____

Gas _____

Oil _____

Total Depth _____

PRODUCTION

1st 24 hrs. Nat. _____

1st 24 hrs. after shot _____

Gas _____ Cu. Ft.

Dry Hole _____

Abandoned _____

Date

OCT 20 1954

19

FABEN GILSTRAP

Scout

