

Graham KANSAS


SEC. 36 TWP. 10 R. 21 W

WELL NO. # 5 Schneider "A" FARM

COMPANY M. B. Armer

CONTRACTOR

SW White Pool
 _____ Ft. from N. Line
 990 _____ Ft. from S. Line
 _____ Ft. from E. Line
 990 _____ Ft. from W. Line

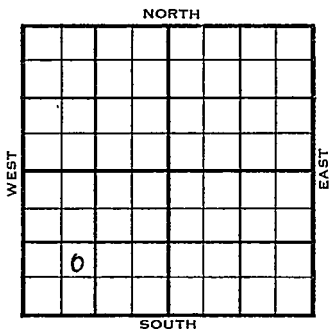

NE SW SW

1954 ELEVATION 2089' REPORT

10/13 Spud 10-8-54
 8" @ 204'
 Drlg. 1900'

12/8 Spud 10-8-54
 Oil Well.
 TD 3674'
 8" @ 204'
 Heeb 3327'; Lans 3365' B KC 3597',
 Cong 3644', Arb. 3665'
 TD 3674'
 5" @ 3665'
 CO to 3674'
 S/ 4 boph 7 hr.
 Comp 176 bopd.

COMPLETED

County Graham State Kansas

Sec. 36 (Blk. 10 (Sur. 21W (Twp.) (Rge.) Map No.

Operator M. B. Armer

Well No. 5 Farm Schneider "A"

Elev. _____ Location NE SW SW

990 Ft. From S Line SW

990 Ft. From W Line Quarter

1st. Report OCT 13 1954

Completion _____

Remarks _____

Spudding Date 10-8-54

Drlg. Data SW White Pool

8" @ 204 drlg. 1900

