


Sherman

**KANSAS**  
39W

SECTION 7 TOWNSHIP 10S RANGE 39W

WELL NO. #1 Thompkins

COMPANY # Phillips Petr.

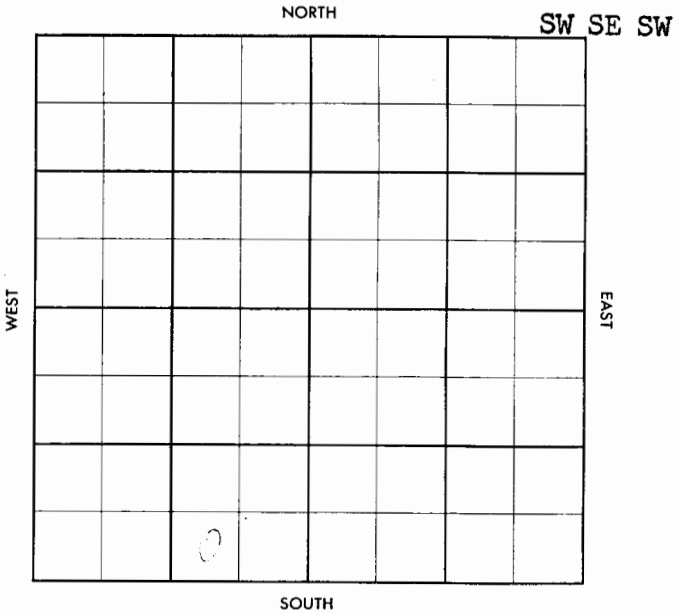

# WILDCAT 2C-0

FORM 513 SUNRAY

County Sherman Elev. \_\_\_\_\_  
Sec. 7 Twp. 10S Rge. 39W  
Company Phillips Pet.  
Farm Name Thompkins No. 1

TOPS	DEPTH	LOG	DATUM	Loc. in Sec. _____
Ank.				<u>SW SE SW</u>
Tp.				
H.				
Tr.				
Dg.				
Bl.				
L.				Geol. _____
K.C.				Conts. _____
B.K.C.				
Ce.				
C.				
M.				
M.				
K.				
Mz.				
Ma.				
V.				
S.				
S.				
A.				
R.				
PE.				
G.				

Co.  
Ph  
V.S.


NO. 7-57

FIRST REPORT

Strat test  
Date Comm. 7-31-57  
8" 131 w/70' 0 2420

32

13out-7in

260 9 in 8 No  
75 feet in hole

FORM 513 SUNRAY

County Sherman Elev. 3643  
 Sec. 7 Twp. 10S Rge. 39W  
 Company Phillips Pet. Nation  
 Farm Name Thompkins (No. 1)

TOPS	DEPTH	LOG	DATUM	Loc. in Sec.
Anh.				SW SW SW
Tr.				
H.				
Tr.				
Dg.				
Bl.				
L.				
K.C.				Geol.
B.K.C.				Contr.
Ce.				
C.				Co.
M.				
M.				Pool
K.				W.C.
Mz.				
Me.				
V.				
S.				
S.				
A.				
R.				
PC.				
G.				

OCT 23 57  
 ABANDONED

Strat test 5801  
 Date Comm. 7-21-57 6 1/4 Hole. Strat test  
 8" 131 w/70; D 2420 AUG 14 57 3743

AUG 21 57 4276 AUG 28 57 SEP 4 57 SEP 11 57  
 SEP 18 57 SEP 25 57 OCT 2 57 OCT 9 57 OCT 16 57  
 OCT 23 57

TIRE

Plugged  
D-1 A