

DX 78-1

Osborne


KANSAS

KANSAS

Section 4 Township 10 Range 15W

Well No. 1 Sara White

Company Trans-Ers & Nate Appleman

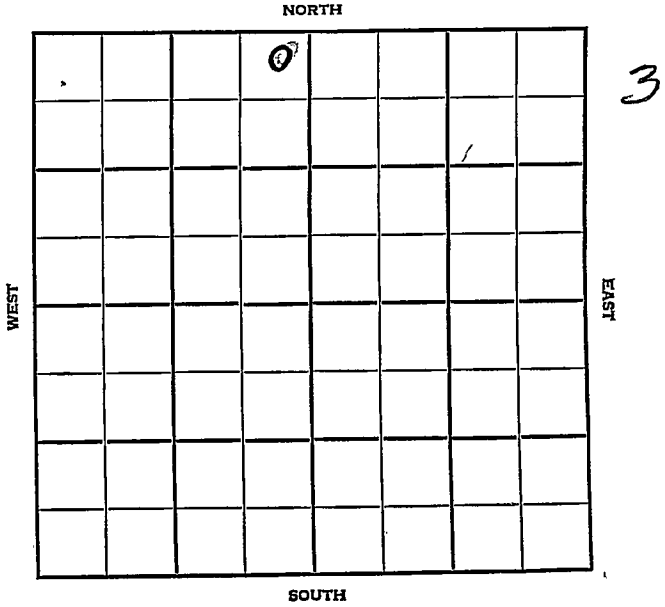

Osborne

KANSAS

10111313

SEC.

4

TWP.

10

R.

15W

WELL NO.

I Sara White

FARM

COMPANY

Trans-Era & Nate Appleman

CONTRACTOR

Co. Tools


Wildcat

_____ Ft. from N. Line

_____ Ft. from S. Line

_____ Ft. from E. Line

_____ Ft. from W. Line

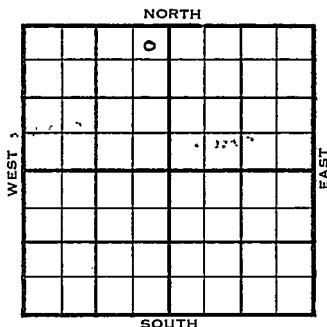

NE NE NW

Superior - FO

1955

ELEVATION

REPORT

6/29
7/29

Location
Abd. Location

ABANDONED

County Osborne Elev. _____
 Sec. 4 Twp. 10 Rge. 15W
 Company Trans-Era & Nate Appleman
 Farm Name Sara White No. 1

TOPS	DEPTH	LOG	DATUM
Anh.			
Tp.			
H.			
Tr.			
Dg.			
Bl.			
L.			
K.C.			
B.K.C.			
Ce.			
C.			
M.			
M.			
K.			
Mz.			
Mg.			
V.			
S.			
S.			
A			
R.			
Pe.			
G.			
T.P.			

Loc. in Sec. NE NE NW

Geol. _____
 Contr. _____
 Co. tools _____

Pool _____
Wildcat

	0	
FIRST REPORT		
JUN 29 '55		

Date Comm. _____ Superior FO
 Location _____

Co.
 Sse.
 No.
 Sec.
 T.
 R.

