


Section 4 Township 10 **KANSAS** Range 18 W

Well No. # 1 Annie Allison

Company D & M Drlg.

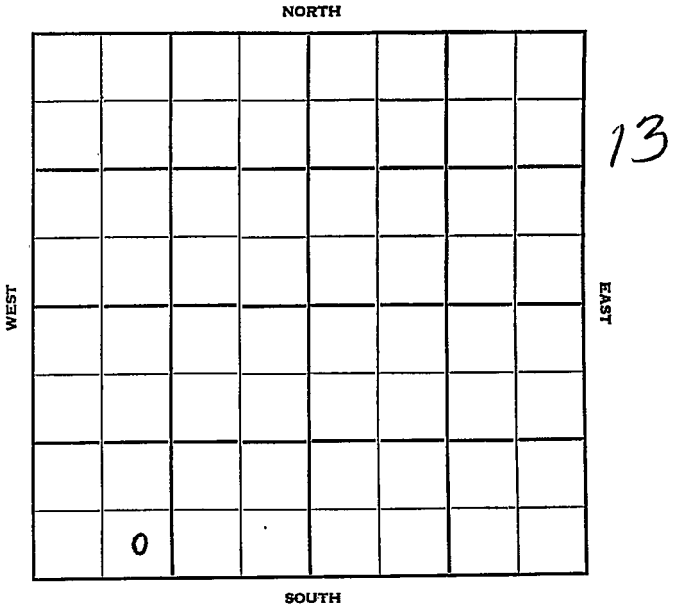

Sec. 4 Twp. 10 R. 18W

Well No. #1 Annie Allison Farm

D & M Drlg. Company

D & M Drlg. Contractor


Williams Pool

 Ft. from N. Line

330 Ft. from S. Line

 Ft. from E. Line

990 Ft. from W. Line

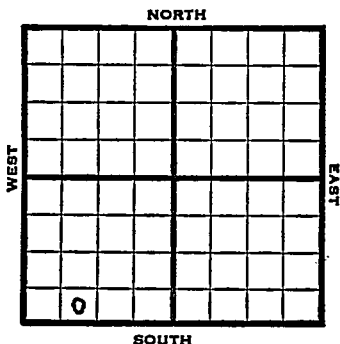

SE SW SW
Magnolia Farmout

1953 Elev. 2185' REPORT

5/20 Spud 5-14-53
8" @ 186
Anhy 1568
Drlg. 3007'

5/27 Spud 5-14-53
D & A
TD 3765'
8" @ 186'
Anhy 1568, Top 3151,
DST 3283-3315 opn 1 hr, rec 63' mud
Heeb 3366, Tor 3384, Lans 3408
DST 3444-76 opn 1 hr, rec 65' mud
Arb 3759
DST 3760-65 opn 1 hr, Rec 1918' wtr.
TD 3765'
D & A

ABANDONED

