


Section 4 Township 10 Range 19W

Well No. #1 Joy

Company W. L. Hartman

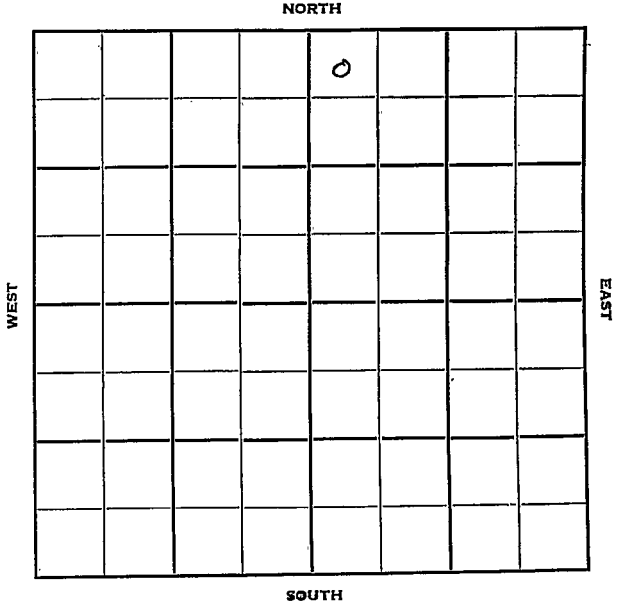

Rooks

Sec. 4 Twp. 10 R. 19W

Well No. #1 Joy Farm

W. L. Hartman Company

B & B Drlg. - Contr. Contractor


330' Ft. from N. Line

_____ Ft. from S. Line

_____ Ft. from E. Line

330' Ft. from W. Line

NW NW NE

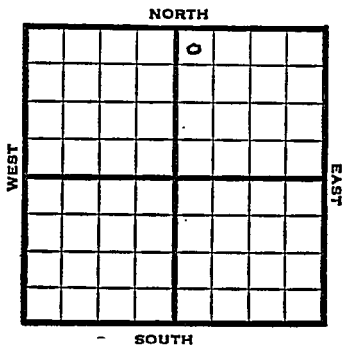

1952

Elev. 2190' REPORT

5/21

Spud 5-17-52
8" @ 159
Anhy 1520-60
Drlg. 1906'

5/28

Heeb 3374' Lans. 3412'
Drlg. 3754'

6/4

Spud 5-17-52
D&A TD 3775
8" @ 159 Anhy 1520-60
Heeb. 3374 Lans. 3412
Tor. 3395 BKC 3636
Cong. 3637 Simp 3694
Arb. 3767 TD 3775

ABANDONED

