

Section 4 Township 10 Range 20-W

Well No. #6 Glick

Company Heathman Drlg.

NORTH

WEST

EAST

SOUTH

Sec. 4 Twp. 10 R. 20-W ✓

Well No. #6 Glick Farm

Heathman Drlg. Company

SE Palco Contractor


 Ft. from N. Line

990 Ft. from S. Line

990 Ft. from E. Line

 Ft. from W. Line

NW SE SE

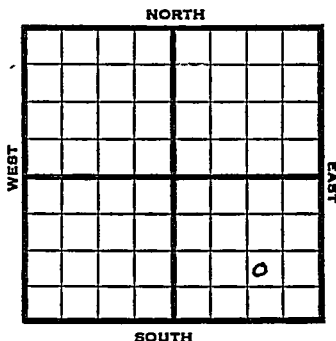

1951

Elev. 2227' REPORT

1/10

RUR

2/21

Spud 1-25-51

Oil well TD 3804

8" @110

Anhy 1710 Heeb. 3460 KC 3499

B KC 3709 Simp. sd. 3782

Simp. sh. 3783 Arb. 3800


5" @3802 TD 3804

FU 1800' oil 5 hr. S/ 15 boph

350 A Comp. 480 bopd

COMPLETED

County Rooks State Kansas
 Sec. 4 (Blk. 10 (Sur. 20W Map No.
 (Twp.) (Rge.)
 Operator Heathman Drlg.
 Well No. 6 Farm Glick
 Elev. Location NW SE SE

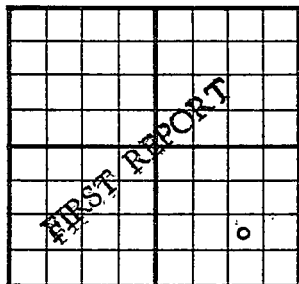

990 Ft. From S Line SE
990 Ft. From E Line Quarter

Ist. Report JAN 10 1950

Completion

Remarks

Spudding Date

Drlg. Data SE - Palco Pool

R U R

J. E. TYRA

J. E. TYRA