

KANSAS

Rooks

Section 4 Township 10 Range 20WWell No. 4 L. HallCompany ContinentalPalco Pool
NORTH

		D					

SOUTH

WEST

EAST

3

KANSAS Rooks

Sec. 4 Twp. 10 R. 20W ✓

Well No. #4 L. Hall Farm

Continental Company


Palco Pool

990' Ft. from N. Line

Ft. from S. Line

990' Ft. from E. Line

Ft. from W. Line

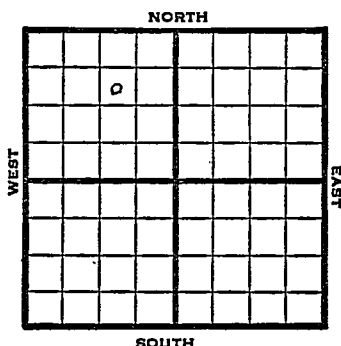

SW NE NW

1949	Elev 2229' REPORT
3/30	Derrick
4/6	"
4/12	10"@ 372'
	Drlg 2524'
4/20	Lansing 3502'
	Drlg 3604'
4/27	Arb. 3807-10'
	TD 3810'
	7"@ 3808'
	Swb 3½ bbls oil PH 4 hrs.
5/4	TD 3812'
	500 acid
	Swb 31 bbls oil / 2½ W 12 hrs.
5/10	"
5/18	"
5/25	TD 3812'
	Arb. 3807'
	7"@ 3808'
	500 acid
	Pump 116 oil / 10 W Pot
	274 Gr.
	Comp
	COMPLETED

Kansas

Map No. _____ Sec. 4 Twp. 10 R. 20WWell No. 4 L. Hall

Continental

Company

FIRST REPORT

Contractor

SW NE NW

SECTION FLAT

990 Ft. from N. Line

_____ Ft. from S. Line

990 Ft. from E. Line

_____ Ft. from W. Line

	6		

Rooks County

RECORD

Location _____

Cased _____ in., _____ ft.

Rig up _____

Sand _____

Drilling and Remarks:

Gas _____

Oil _____

Derrick

Total Depth _____

PRODUCTION

1st 24 hrs. Nat. _____

1st 24 hrs. after shot _____

Gas _____ Cu. Ft.

Dry Hole _____

Abandoned _____

Date

MAR 30 1949

19

S. J. LEWIS

Scout

Map No. K65 Sec. 4 Twp. 10 R. 20W

Well No. 4 L. Hall

Continental Company

COMPLETE Contractor

SW NE NW


E1.2229
SECTION PLAT

990 Ft. from N. Line

 Ft. from S. Line

990 Ft. from E. Line

 Ft. from W. Line

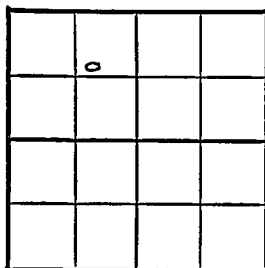

Rooks County

Location

Rig up

Drilling and Remarks:

Cr 3809
7" @ 3808
5000 cu ft
Pump 116 oil + 10W
Box
27 1/2 ft

RECORD

Cased in., ft.

Sand

Gas

Oil

Total Depth 3872

PRODUCTION

1st 24 hrs. Nat.

1st 24 hrs. after shot

Gas Cu. Ft.

Dry Hole

Abandoned

Date

MAY 25 1949 19

S. J. LEWIS Scout