


Section 4 Township 10 Range 20 WWell No. # 1 TownsCompany Heathman

NORTH

WEST

EAST

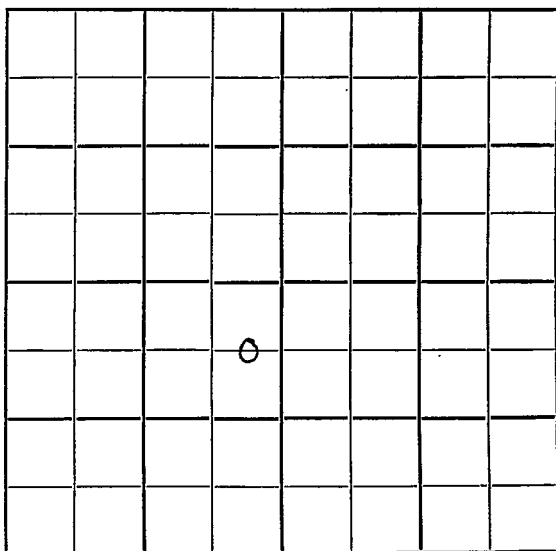

SOUTH


Sec. 4 Twp. 10 R. 20WWell No. #1 Towns FarmHeathman CompanyPalco Pool Contractor660 Ft. from N. Line

Ft. from S. Line

330 Ft. from E. Line

Ft. from W. Line

C E L N E S W

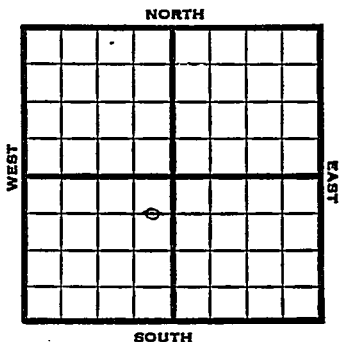

1951

Elev. 2243' REPORT

10/3

Spud 9-27-51

8" @ 141

1727 Anhy

Drlg. 2414

12/19

Spud 9-27-51

Oil Well TD 3839

8" @ 141'

Anhy 1727

Top. 3276-

Heeb. 3498

Lans. 3518

B KC 3742

Cong. 3770

Simp. 3809

Arb. 3829

DST 3831-34 open 1 hr. rec. 12' mud

DST 3831-39 open 20 min. rec. 800'

oil TD 3839 5" @ 3836

CO to 3839' FU 400' oil

S/ 14 BFPH 50 % wtr. PB 3834

9/ 3829-31 9/ 3831-33

9/ 3930-32 B/ 2 BO 2 GWPH

350 A S/ 20 BOPH dec. to

12 BFPH 50% wtr. CO to 3832

16/ 3828-31 12/ 3828-31

CO to 3834 16/ 3829-33 SSO

S/ 4 GOPH 500 A S/ 16 BOPH

50% wtr. Comp. 217 BOPD 50% wtr.

COMPLETED

County Books State Kansas

Sec. 4 (Blk. 10) (Sur. 20W) Map No. _____

Operator **Heathman**

Well No. **1** Farm **Towns**

Elev.	Location
C E L NE SW	

FIRST REPORT

660 Ft. From N Line SW

330 Ft. From E Line Quarter

1st. Report **OCT 3 1951**

Completion

Remarks


Spudding Date 9-27-51

Drlg. Data Palco Pool

8ⁿ @ 141 Anhy 1727 drlg. 2414

J. E. TYRA

County Rooks State Kansas
 Sec. 4 (Blk. 10 (Sur. 20W Map No. 20W)
 (Twp.) (Rge.)
 Operator Heathman & Co.
 Well No. 1 Farm Towns
 Elev. 2243 Location C E L NE SW

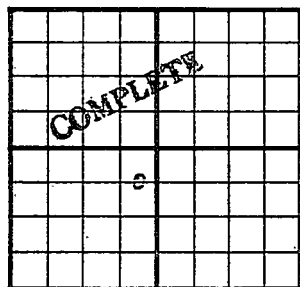

660 Ft. From N Line SW
330 Ft. From E Line Quarter
 Ist. Report
 Completion DEC 1 9 1951
 Remarks Palco Pool

Spudding Date 9-27-51

Drlg. Data Oil well TD 3839
8" @ 141 Anhy 1727 Top. 3276
Heeb. 3498 Lans. 3518 B KC 3742
Cong. 3770 Simp. 3809 Arb. 3829
DST 3831-34 open 1 hr. Rec. 12'
mud DST 3831-39 open 20 min.
Rec. 800' oil TD 3839 5" @ 3836
C0 to 3839 FU 400' oil S/ 14 bfph
50% water PB 3834 9/ 3829-31
9/ 3831-33 9/ 3930-32
B/ 2 bo 2 gwph 350 A S/ 20 boph
dec. to 12 bfph 50% water C0 to
3832 16/ 3828-31 12/ 3828-31
C0 to 3834 16/ 3829-33 SS0
S/ 4 goph 500 A S/ 16 boph

JL E. TYRA

Drlg. Data

50% water Comp. 217 bopd 50% water

JAN 2 1952

Scout Cards	
Land Small Map	
Land Wall Map	
Tracings	
France Map	
P. Price Map	
Misc	

217