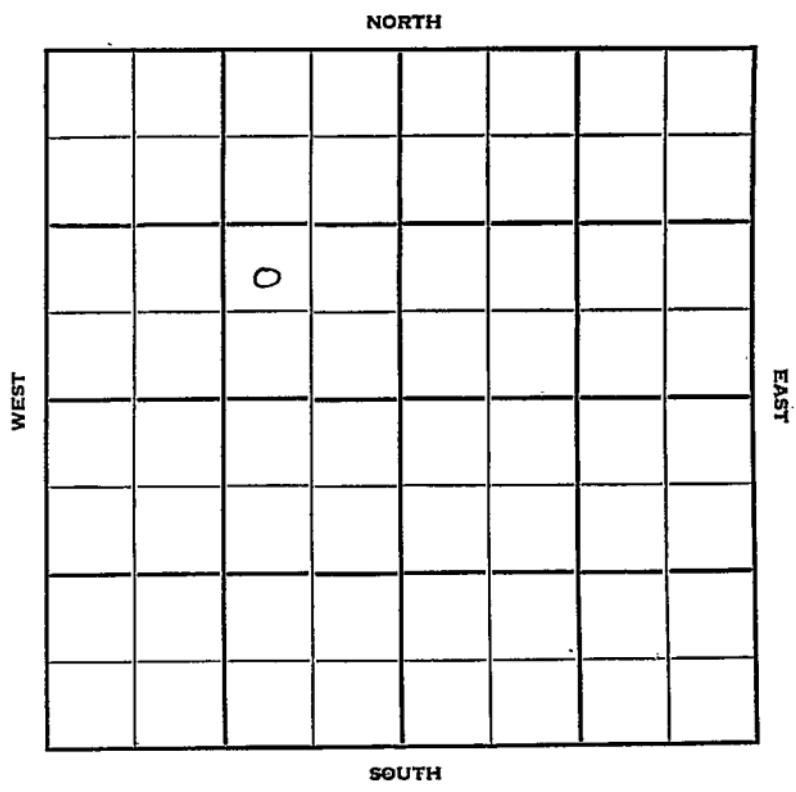


Section 4 Township 10 Range 19WWell No. #4 AndresonCompany Stableford & K & E Drlg.

Sec. 4 Twp. 10 R. 19 WWell No. # 4 Andreson FarmStableford & K & E Drilg. Company

Contractor


Lynd Pool

Ft. from N. Line

990 Ft. from S. Line990 Ft. from E. Line

Ft. from W. Line

NW SE NW

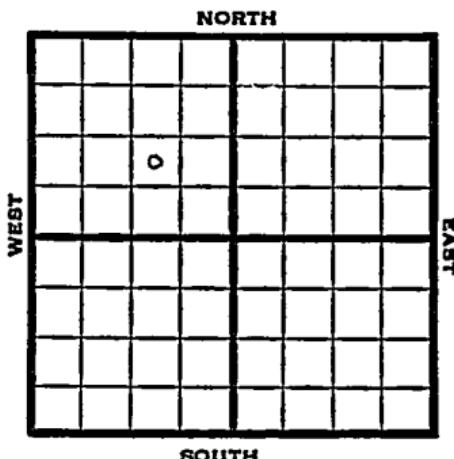1951 | **Elev. 2213' REPORT**

9/12 Location

9/19 Location Abandoned


ABANDONED

County Rooks State Kansas
 Sec. 4 (Blk.) 10 (Sur.) 19W Map No.

Operator Stableford & K. & E. Drilg.

Well No. 4 Farm Anderson

Elev. Location NW SE NW

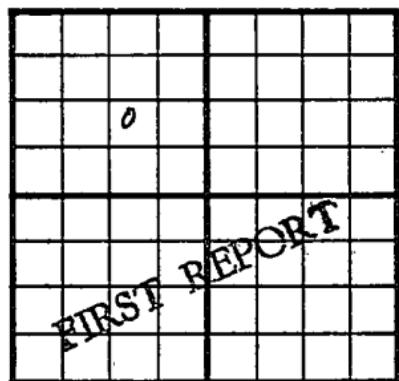

990 Ft. From S Line NW

990 Ft. From E Line Quarter

1st. Report SEP 12 1951

Completion

Remarks

Spudding Date

Drilg. Data

Lynd Pool

Location

J. E. TYRA

County	Rooks	State	Kansas			
Sec.	4	(Blk.) (Twp.)	10	(Sur. Rge.)	19W	Map No.
Operator	Stableford & K & E Drlg.					
Well No.	4	Farm	Andreson			
Elev.	2213	Location	NW SE NW			
o			990 Ft. From	S Line	NW	
ABANDONED			990 Ft. From	E Line	Quarter	
1st. Report						
Completion SEP 19 1951						
Remarks Lynd Pool						
Spudding Date						

Drlg. Data

Location abd.

J. E. TYRA