

O.W.D.D

Section 4 Township 10 Range 21W

Well No. 18 Rudeman "B"

Company Natural Gas & Oil ROCKET DRUG.

NORTH

0							

WEST

EAST

SOUTH

O.W.D.D.

Graham

KANSAS

SEC.	TWP.	R.
4	10	21 W ✓

WELL NO. # ¹ Rudeman "B" FARM

COMPANY

CONTRACTOR ~~Natural Gas & Oil~~ ROCKET DRILG.


Cooper Pool

_____ Ft. from N. Line

990 _____ Ft. from S. Line

_____ Ft. from E. Line

330 _____ Ft. from W. Line

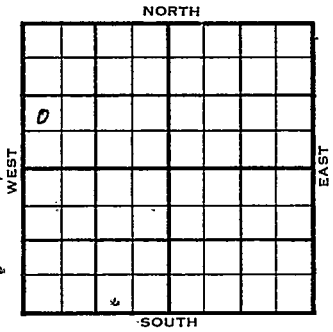

NW SW NW

	ELEVATION	REPORT
1954	2315'	

2/24 MIR

3/3 8" @ 160 w/125
Drlg. 3150'

3/10 Spud 2-24-54 D & A TD 3937
8" @ 160 Anhy 1780
DST 3335-42 open 3/4 hr rec 80' SW
1080# Heeb 3511 Tor 3532
Lans 3550
DST 3555-92 open 1/2 hr rec 5' SW
DST 3716-55 open 1/2 hr rec 35' mud
1050# Arb. 3894
DST 3895-99 open 1 hr rec 35' oil
30' HOCM, 30' SOCM, 30' WCM, 30' SW
830#
DST 3899-3904 open 1 hr. rec 180' SOCM
60' SW 770#
DST 3904-09, open 1 hr rec 80' SW 570#
TD 3937' D & A

ABANDONED

OVER

1955

O.W.D.D

2/23

Arb. 3895'
OTD 3937'
DD 3941'
5" @ 3941'
CO to 3941
3/ 3894-95 3/ 3895-96
SSO 3/ 3896-97 S/ 8 to 10 goph
6/ 3895-97 500 A S/ 6 $\frac{1}{2}$ bfph 15 hr.
(50% oil,) POP

4/6

Oil Well; TD 3941; Arb 3895,
otd 3937, DD 3941, 5" @ 3941
CO to 3941, 3/3894-95, 3/3895-
96, SSO, 3/3896-97, S/8 to 10
GOPH 6/3895-97, 500 A S/6 1/2
BFPH 15 hr. P/75 BOPD 75 BW
Comp. 25 BOPD 52% wtr.

COMPLETED

County Graham State Kansas

Sec. 4 (Blk. 10 (Sur. 21W (Twp. Map No.)

Operator Natural Gas & Oil

Well No. 2 Farm Rudeman "B"

Elev. _____ Location NW SW NW

o					

990 Ft. From S Line NW

330 Ft. From W Line Quarter

1st. Report FEB 24 1954

Completion _____

Remarks _____

Spudding Date _____

Drig. Data Cooper Pool

M I R

County Graham State Kansas

Sec. 4 (Blk.) 10 (Sur.) 21W Map No. (Twp.) (Rge.)

Operator Natural Gas & Oil

Well No. 2 Farm Rudeman "B"

Elev. 2315 Location NW SW NW

990 Ft. From S Line NW

330 Ft. From W Line Quarter

Ist. Report

Completion MAR 10 1954

Remarks Cooper Pool

Spudding Date 2-24-54

Drlg. Data D & A TD 3937

8" @ 160 Anhy 1780 DST 3335-42

open 3/4 hr. Rec. 80' sw 1080#

Heeb. 3511 Tor. 3532 Lans. 3550

DST 3555-92 open 1/2 hr. Rec. 5' sw

DST 3716-55 open 1/2 hr. Rec. 35' mud

1050# Arb. 3894 DST 3895-99 open 1 hr.

Rec. 35' oil 30' hocm 30' socm 30' wcm

30' sw 830# DST 3899-3904 open 1 hr.

Rec. 180' socm 60' sw 770# DST 3904-

09. open 1 hr. Rec. 80' sw 570#

TD 3937

D & A

SCOUT TICKET

Kansas

SEC.

TWP.

R.

4

10

21W

WELL NO.

1 Rudeman

FARM

COMPANY

Rocket Drlg.

CONTRACTOR

CORRECTION

NW SW NW


NORTH

_____ FT. FROM N. LINE

990 FT. FROM S. LINE

_____ FT. FORM E. LINE

330 FT. FROM W. LINE

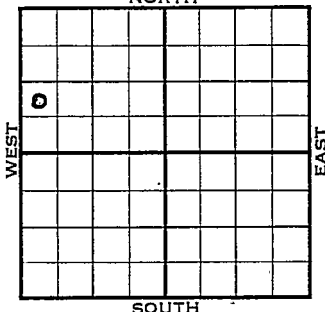

Graham County

LOCATION

RIG UP

DRILLING AND REMARKS

OWDD

Was Nat. Gas & Oil
#2 Rudeman

RECORD

CASED IN., FT.

SAND

GAS

OIL

TOTAL DEPTH

1ST 24 HRS. NAT.

1ST 24 HRS. AFTER SHOT

GAS CU. FT.

DRY HOLE

ABANDONED

PRODUCTION

DATE

SCOUT

MAR 9 1955

FABEN GILSTRAP

County Graham State Kansas

Sec. 4 (Blk.) 10 (Sur.) 21W Map No.

Operator Rocket Drlg.

Well No. 1 Farm Rudeman

Elev. 2318 Location NW SW NW

990 Ft. From S Line NW

330 Ft. From W Line Quarter

1st. Report

Completion APR 6 1955

Remarks OWDD

Spudding Date

Drlg. Data Oil well TD 3941

Arb. 3895 OTD 3937 DD 3941 5" @ 3941

CO to 3941 3/ 3894-95 3/ 3895-96

SSO 3/ 3896-97 S/ 8 to 10 goph

6/ 3895-97-- 500 A S/ 6 $\frac{1}{2}$ bfph 15 hr.

P/ 75 bopd 75 bw

Comp. 25 bopd .52% wtr.

FABEN GILSTRAP