


Books

KANSAS

Section 5 Township 10 Range 18W

Well No. #1 Hilgers

Company N C R A

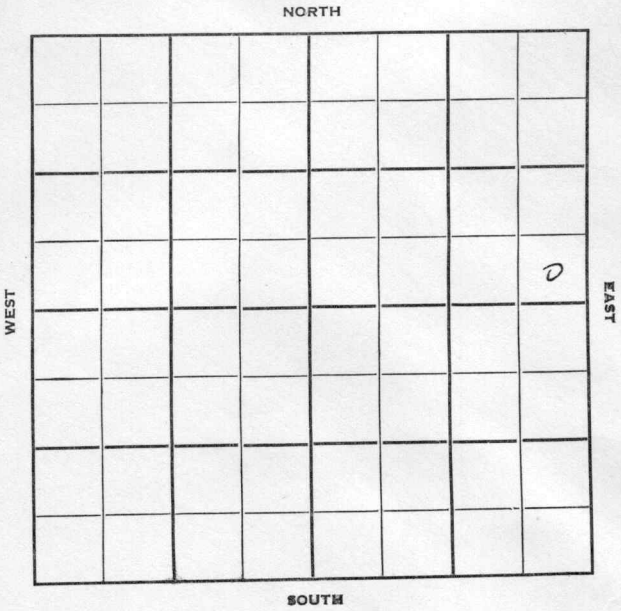

Rooks

Sec. 5 Twp. 10 R. 18W

Well No. #1 Hilgers Farm

N C R A

Company

Linds

Contractor

Wildcat

Ft. from N. Line

330'


Ft. from S. Line

330'

Ft. from E. Line

Ft. from W. Line

SE NE

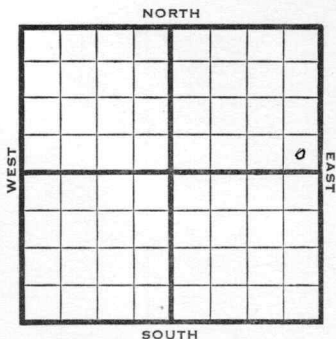

1949

Elev 2179'

REPORT

11/2

Location

11/9

8" @ 160'

Drlg. 2270'

11/23

TD 3782'

Arb. 3757'

Aband.

ABANDONED

Map No. _____ Sec. 5 Twp. 10 R. 18W

Well No. 1 Hilgers

N C R A

Company

Lindas

Contractor

SE NE

**FIRST REPORT
SECTION PLAT**

_____ Ft. from N. Line

330 Ft. from S. Line

330 Ft. from E. Line

_____ Ft. from W. Line

Rooks County

Location X

Rig up _____

Drilling and Remarks:

RECORD

Cased _____ in., _____ ft.

Sand _____

Gas _____

Oil _____

Total Depth _____

PRODUCTION

1st 24 hrs. Nat. _____

1st 24 hrs. after shot _____

Gas _____ Cu. Ft.

Dry Hole _____

Abandoned _____

Date

NOV 2 1949 19

S. J. LEWIS Scout

Kansas

Map No. _____ Sec. 5 Twp. 10 R. 18WWell No. 1 Hilgers


N C R A

Company

ABANDONED

Contractor

SE NE

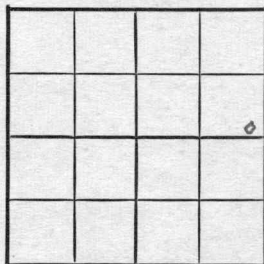E1.2179
SECTION PLAT

_____ Ft. from N. Line

330 Ft. from S. Line330 Ft. from E. Line

_____ Ft. from W. Line

Rooks County

Location _____

Rig up _____

Drilling and Remarks:

Cu x 3257

RECORD

Cased _____ in., _____ ft.

Sand _____

Gas _____

Oil _____

Total Depth 3282

PRODUCTION

1st 24 hrs. Nat. _____

1st 24 hrs. after shot _____

Gas _____ Cu. Ft.

Dry Hole _____

Abandoned _____

Date

NOV 23 1949

19

S. J. LEWIS

Scout